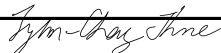


High Priority

CONTRACTOR SUBMITTAL TRANSMITTAL FORM REV. A

Owner: County of Hawaii
Contractor: Nan, Inc. Project No.: WW-4705R
Project Name: Hilo WWTP Phase 1 Submittal Number:
Submittal Title: For Information Only
TO:
From: Nan Inc.

Specification No. and Subject of Submittal / Equipment Supplier	
Spec:	Paragraph:
Authorized By:	Date Submitted:

Submittal Certification		
Check Either (A) or (B):		
☐ (A)	We have verified that the equipment or material contained in this submittal meets all the requirements specified in the project manual or shown on the contract drawings with <u>no exceptions</u> .	
☐ (B)	We have verified that the equipment or material contained in this submittal meets all the requirements specified in the project manual or shown on the contract drawings <u>except</u> for the deviations listed.	
Certification Statement: By this submittal, I hereby represent that I have determined and verified all field measurements, field construction criteria, materials, dimensions, catalog numbers and similar data, and I have checked and coordinated each item with other applicable approved shop drawings and all Contract requirements.		
General Contractor's Reviewer's Signature: 		
Printed Name and Title:		
In the event, Contractor believes the Submittal response does or will cause a change to the requirements of the Contract, Contractor shall immediately give written notice stating that Contractor considers the response to be a Change Order.		
Firm:	Signature:	Date Returned:

PM/CM Office Use
Date Received GC to PM/CM:
Date Received PM/CM to Reviewer:
Date Received Reviewer to PM/CM:
Date Sent PM/CM to GC:

Nan, Inc

PROJECT: HILO WWTP REHABILITATION
AND REPLACEMENT PROJECT - PHASE 1

JOB NO. WW-4705R

THIS SUBMITTAL HAS BEEN CHECKED BY
THIS CONTRACTOR. IT IS CERTIFIED
CORRECT, COMPLETE, AND IN
COMPLIANCE WITH CONTRACT
DRAWINGS AND SPECIFICATIONS. ALL
AFFECTED CONTRACTORS AND
SUPPLIERS ARE AWARE OF, AND WILL
INTEGRATE THIS SUBMITTAL (UPON
APPROVAL) INTO THEIR OWN WORK.

DATE RECEIVED _____
SPECIFICATION SECTION # _____
SPECIFICATION _____
PARAGRAPH _____
DRAWING _____
SUBCONTRACTOR _____
SUPPLIER _____
MANUFACTURER _____

CERTIFIED BY CQCM or Designee: 

Review Comments:

1. Refer to attached PDF for comments. Verify and address all comments.
Incorporated in the attachments.
2. The Contractor shall verify and/or confirm all clouded items, unless otherwise noted.
Incorporated in the attached drawings with clouds.
3. The Contractor shall verify and confirm locations, dimensions, and height of all equipment pads.
Incorporated in the attached drawings with clouds.
4. Refer to Keynote 3 on Drawing 02-S-01-106. The Contractor shall verify and confirm diameter and wall thickness of grit basin tank structures.
Incorporated in the attached drawings with clouds.
5. The Contractor shall verify and coordinate all openings required per the mechanical and electrical drawings and provide additional reinforcement per S144/TYP.
Incorporated in the attached drawings with clouds.


- b. Details, properties, and dimensions of couplers. Include type or size identification, and bar size(s) and grade(s) for which the coupler is suitable.
- c. Manufacturer's installation and testing instructions.
- d. Manufacturer's statement that products installed in accordance with manufacturer's recommended procedures will develop strengths and limit slip as specified in this Section.

 C Shop drawings:





1. Reinforcement shop drawings:
 - a. Submit drawings showing bending and placement of reinforcement required by the Contract Documents.
 - b. Clearly indicate structures or portions of structures covered by each submittal.
 - 1) Submit reinforcement shop drawings for each structure as a complete package. Submittals addressing only a portion of a structure will be rejected and returned without review, unless such presentation is accepted by Engineer in advance.
 - c. Shop drawings shall conform to the recommendations of the CRSI Manual of Standard Practice and ACI SP-66.
 - d. Use the same bar identification marks on bending detail drawings, placement drawings, and shipping tags.
 - e. Submittals consisting solely of reinforcing bar schedules, without accompanying placement drawings, will not be accepted unless accepted under prior written agreement with Engineer.
2. Reinforcement placement drawings:
 - a. Clearly show placement of each bar listed in the bill of materials, including additional reinforcement at corners and openings, and other reinforcement required by details in the Contract Documents.
 - b. Clearly identify locations of reinforcement with coatings (e.g., galvanized or epoxy) and with yield strength other than ASTM A615, Grade 60.
 - c. Show anchor bolt locations based on anchor bolt templates for approved equipment.
 - d. Show splice locations.
 - e. Show locations of mechanical reinforcing couplers, if used.
3. Reinforcement fabrication drawings:
 - a. If bend types or nomenclature differs from that recommended in the CRSI Manual of Standard Practice, provide details showing bend types and dimensional designations.
Clearly identify reinforcement with coatings and with yield strength other than ASTM A615, Grade 60.

D. Samples (when requested by Engineer):

1. Bar supports/wire reinforcement supports: Samples of each type of chair and bolster proposed for use. Submit with letter stating where each type will be used.
2. Precast concrete bar supports: Samples of each type of precast support proposed for use. Submit with letter stating where each will be used.

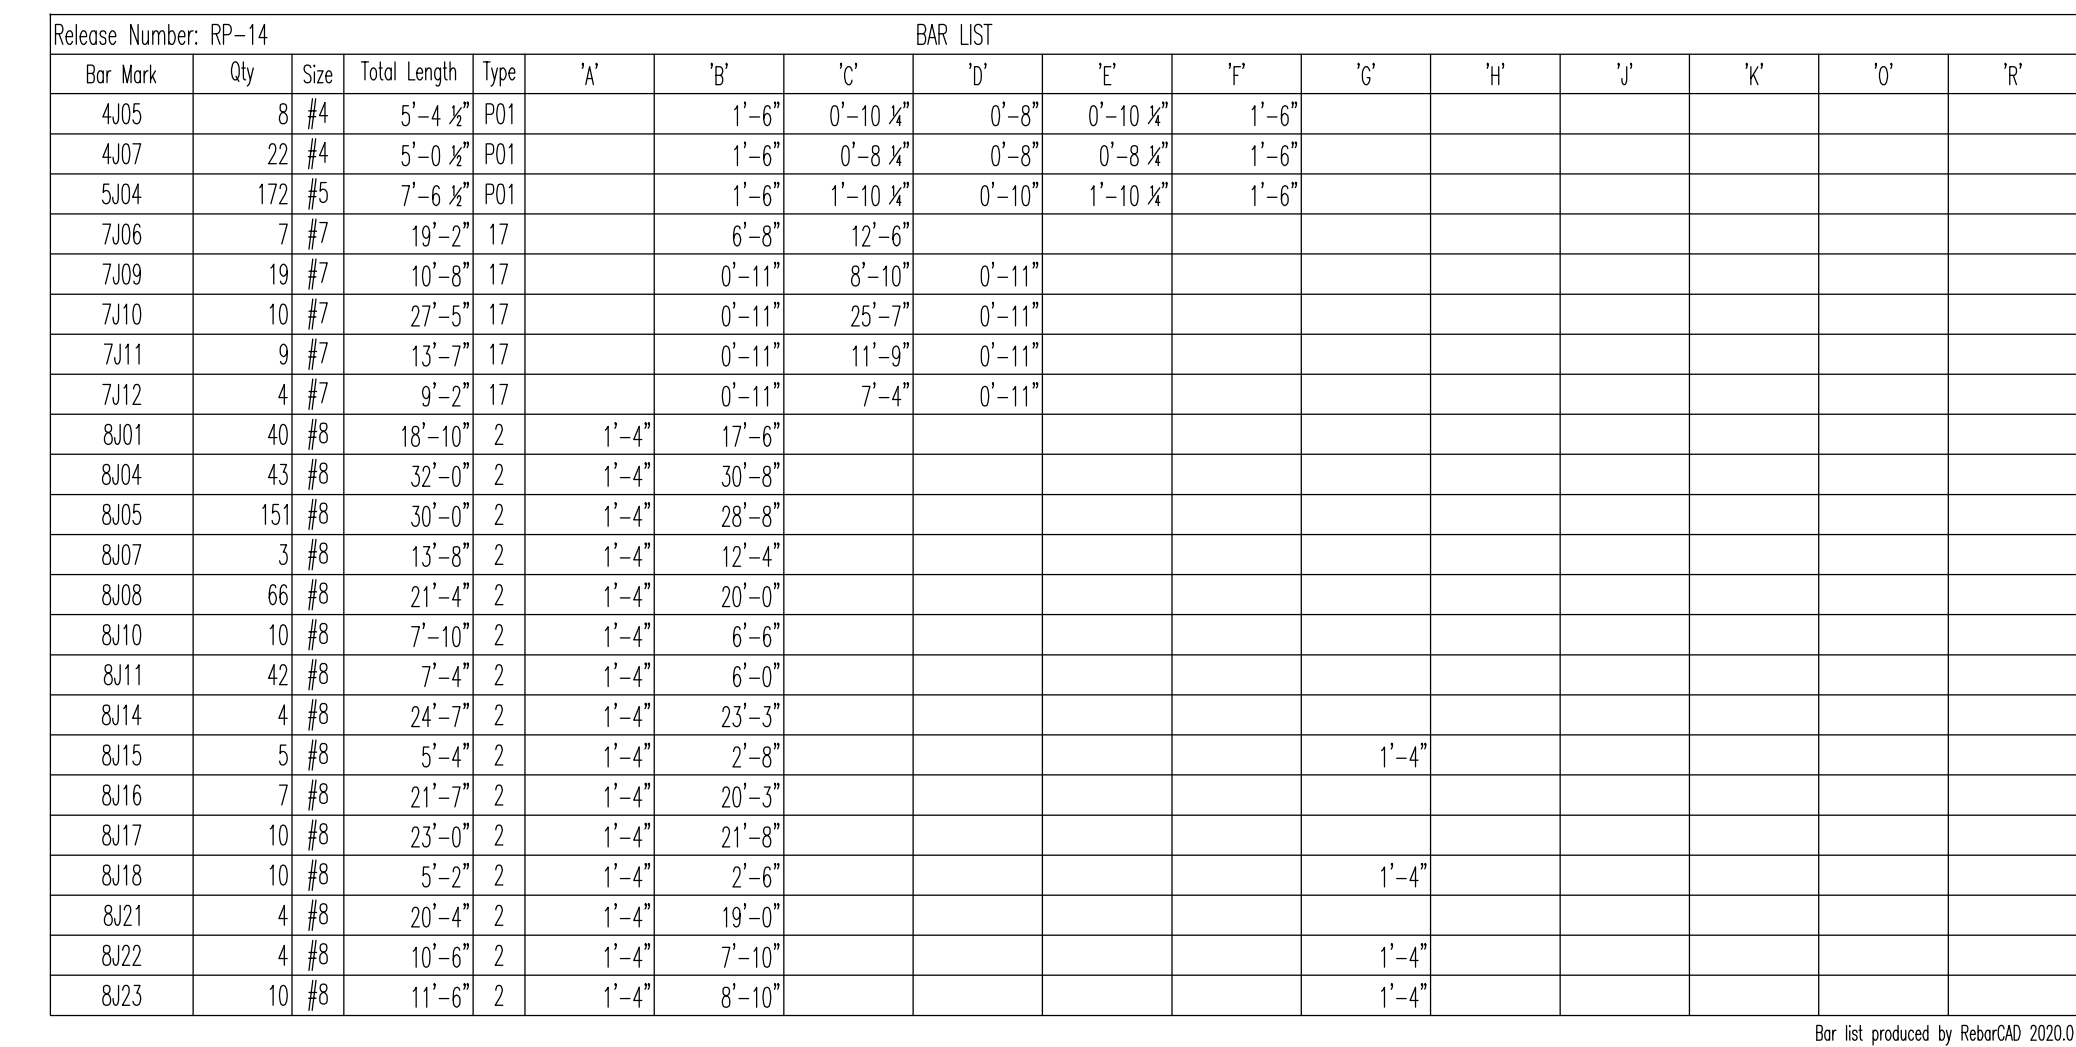


ABBREVIATIONS		LAP SCHEDULE		
BOTTOM	B	SIZE	4000 PSI	
TOP&BOTTOM	T&B		TOP	OTHERS
CONTINUOUS	CONT.	#4	20"	16"
CORNER BAR	COR.	#5	26"	20"
HORIZONTAL	H	#6	30"	24"
EACH WAY	EW	#7	43"	33"
EACH FACE	EF	#8	50"	38"
INNER FACE	IF	#9	56"	42"
OUTER FACE	OF	#10	62"	48"
EACH SIDE	ES	#11	69"	54"
DOWEL	DWL.			
LONG WAY BAR	LW			
SHORT WAY BAR	SW			
REFERENCE	REF.			

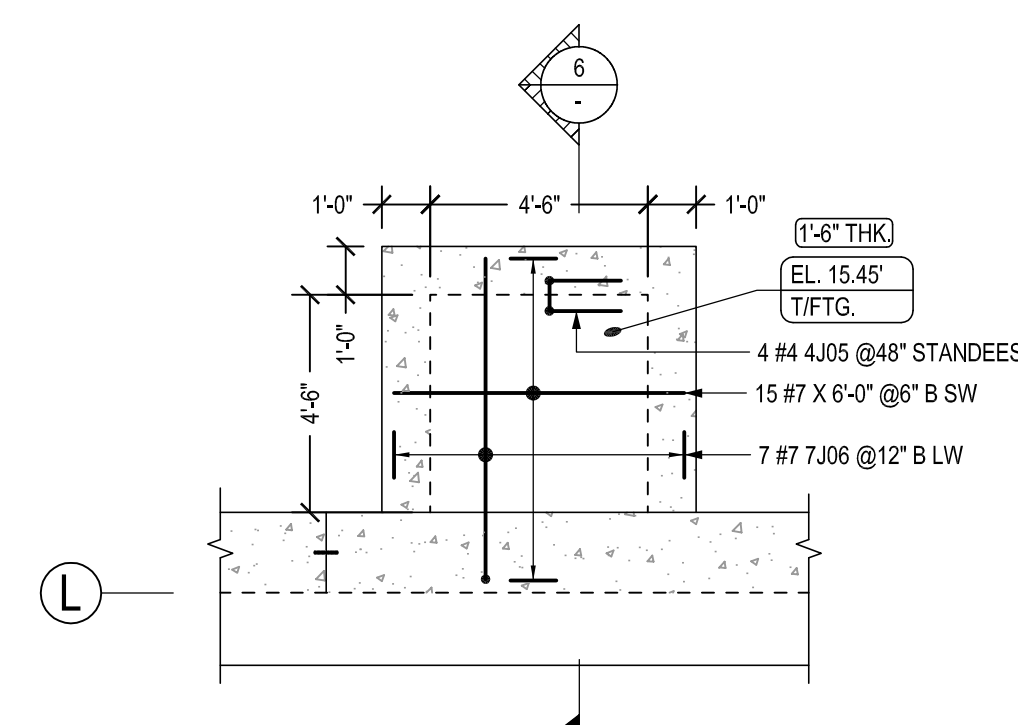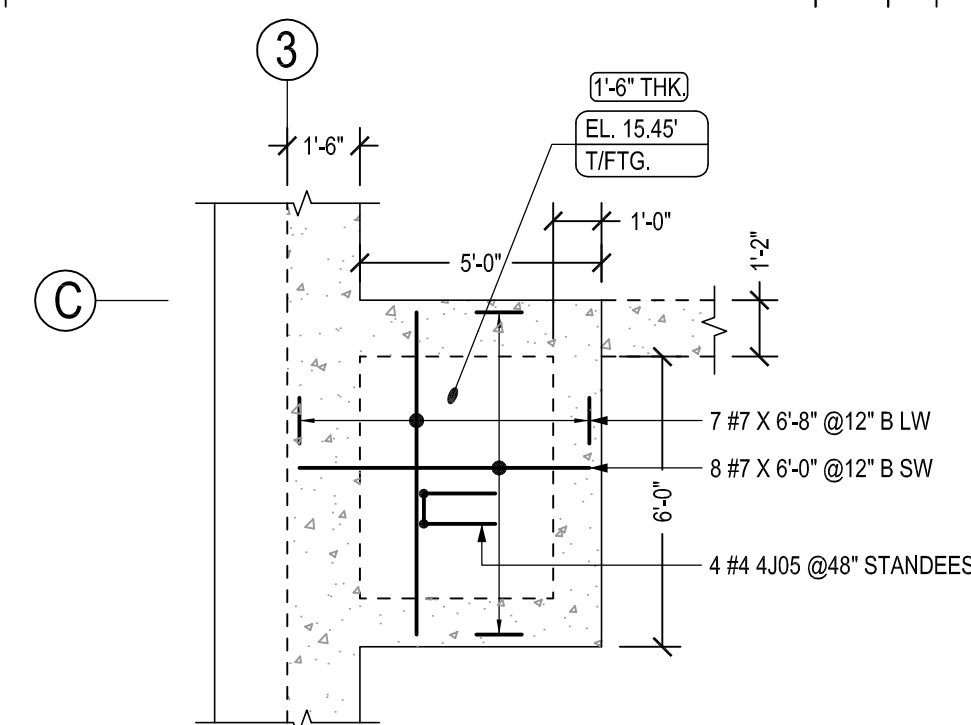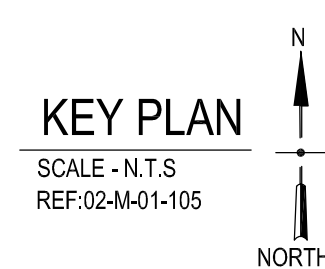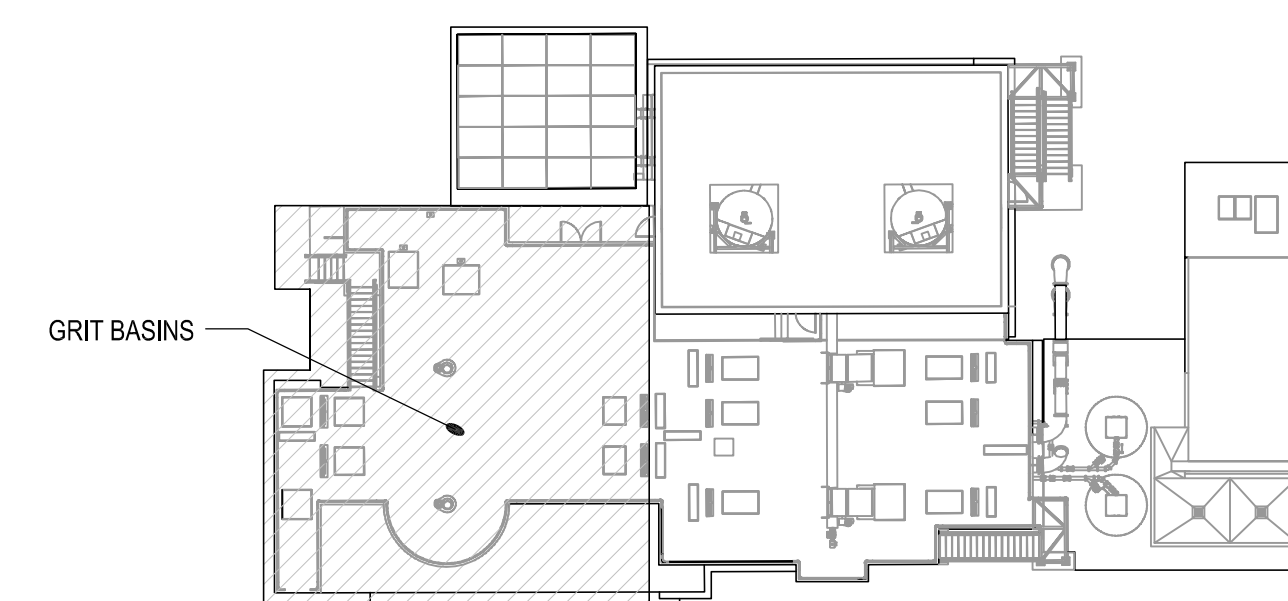


DETAIL A
SCALE - 1/4"=1'-0"
REF:02-S-01-105

DETAIL (B)
SCALE - 1/4"=1'-0"
REF:02-S-01-105


ALL REINFORCEMENTS ARE A615 GR.60 U.N.O

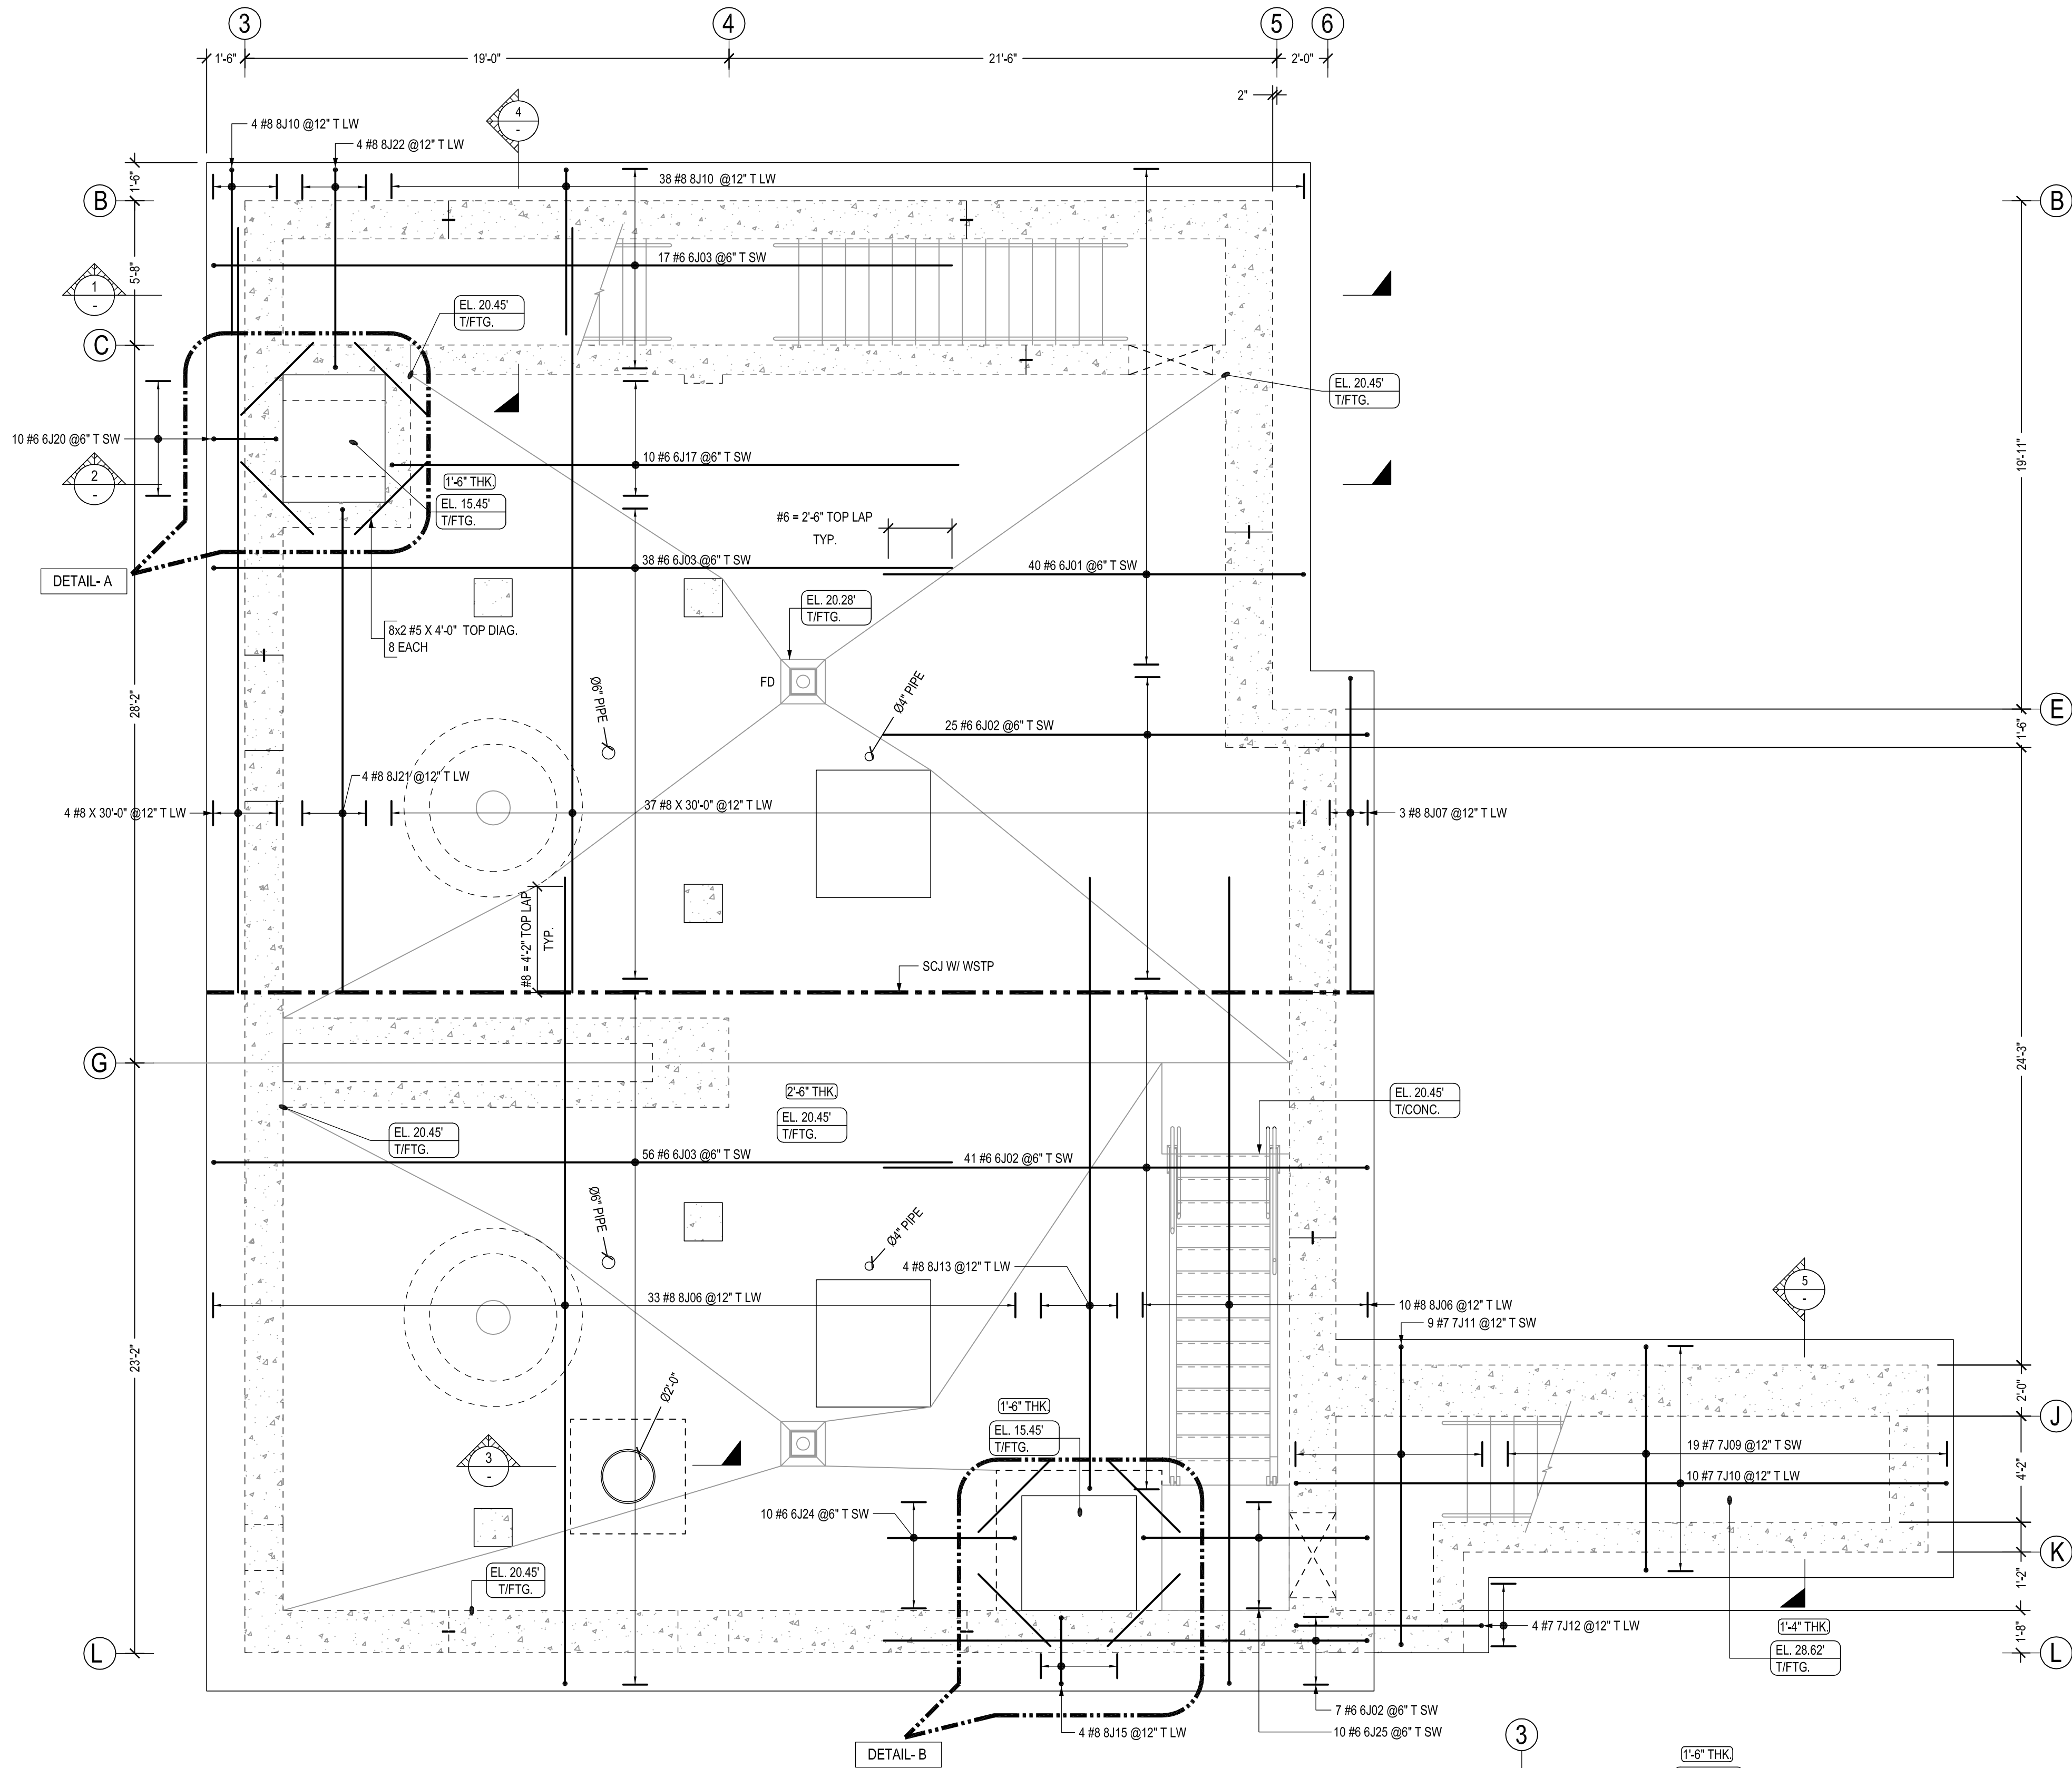

TOP EACH WAY REINFORCEMENT DETAILS
GRIT BASINS - BASE SLAB REINFORCEMENT LAYOUT
SCALE - 1/4"=1'-0"
REF:02-S-01-105

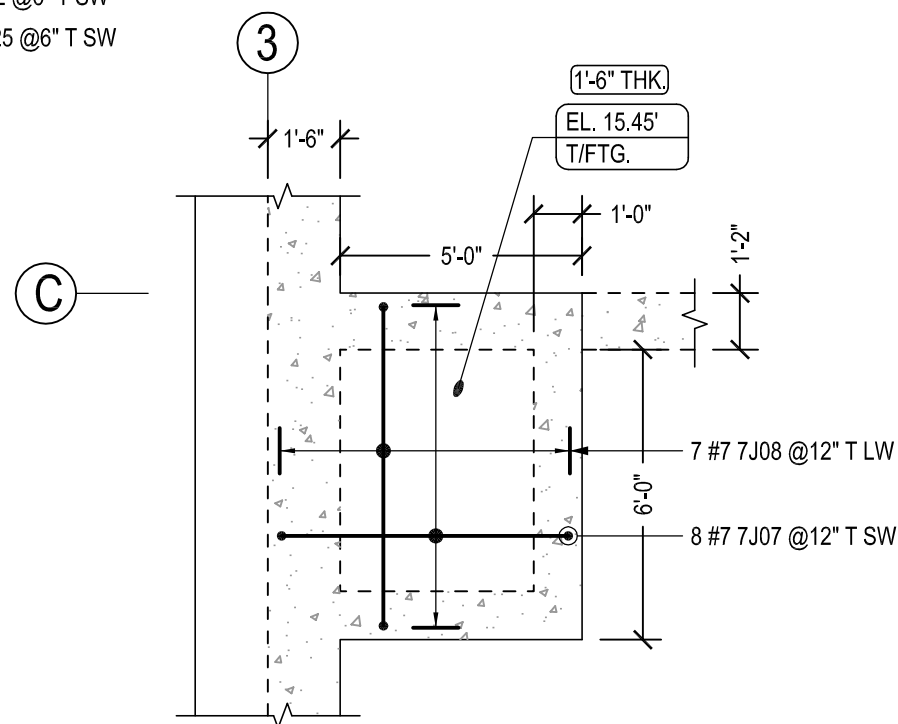


DETAIL A
SCALE - 1/4"=1'-0"
REF:02-S-01-105

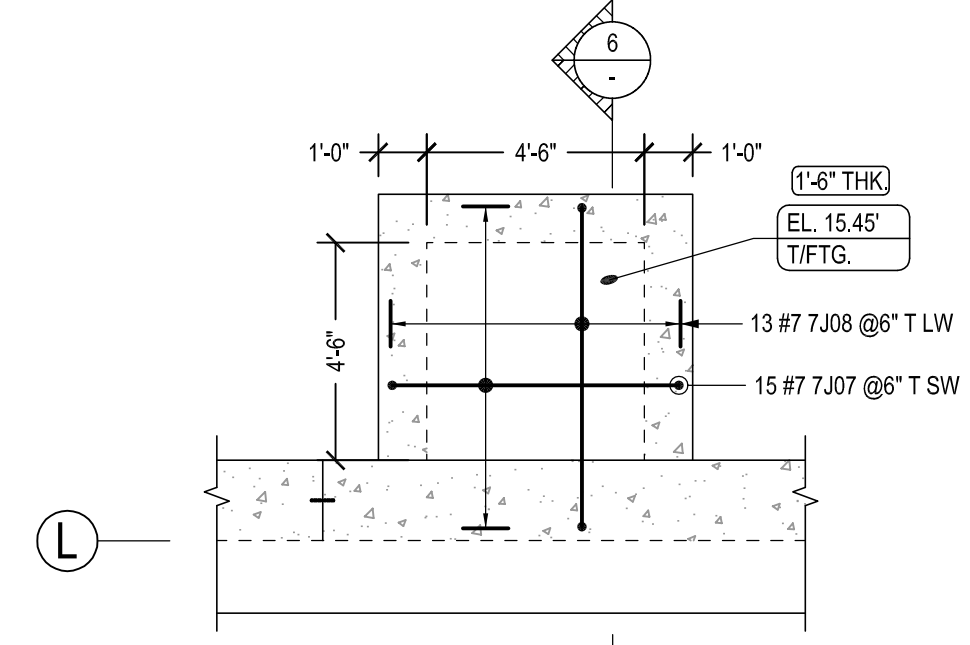

DETAIL B
SCALE - 1/4"=1'-0"
REF:02-S-01-105


Release Number: RP-15				BAR LIST												
Bar Mark	Qty	Size	Total Length	Type	'A'	'B'	'C'	'D'	'E'	'F'	'G'	'H'	'J'	'K'	'U'	'R'
6J01	40	#6	17'-6"	2	1'-0"	16'-6"										
6J02	73	#6	20'-0"	2	1'-0"	19'-0"										
6J03	111	#6	30'-0"	2	1'-0"	29'-0"										
6J17	10	#6	23'-3"	2	1'-0"	22'-3"										
6J20	10	#6	4'-6"	2	1'-0"	2'-6"						1'-0"				
6J24	10	#6	6'-0"	2	1'-0"	5'-0"										
6J25	10	#6	10'-10"	2	1'-0"	8'-10"						1'-0"				
7J07	23	#7	8'-4"	2	1'-2"	6'-0"								1'-2"		
7J08	20	#7	9'-0"	2	1'-2"	6'-8"								1'-2"		
7J09	19	#7	10'-8"	17		0'-11"	8'-10"	0'-11"								
7J10	10	#7	27'-5"	17		0'-11"	25'-7"	0'-11"								
7J11	9	#7	13'-7"	17		0'-11"	11'-9"	0'-11"								
7J12	4	#7	9'-2"	17		0'-11"	7'-4"	0'-11"								
8J06	43	#8	33'-0"	2	1'-4"	31'-8"										
8J07	3	#8	13'-8"	2	1'-4"	12'-4"										
8J10	42	#8	7'-10"	2	1'-4"	6'-6"										
8J13	4	#8	25'-4"	2	1'-4"	24'-0"										
8J15	4	#8	5'-4"	2	1'-4"	2'-8"						1'-4"				
8J21	4	#8	20'-4"	2	1'-4"	19'-0"										
8J22	4	#8	10'-6"	2	1'-4"	7'-10"						1'-4"				

Bar list produced by RebarCAD 2020.0

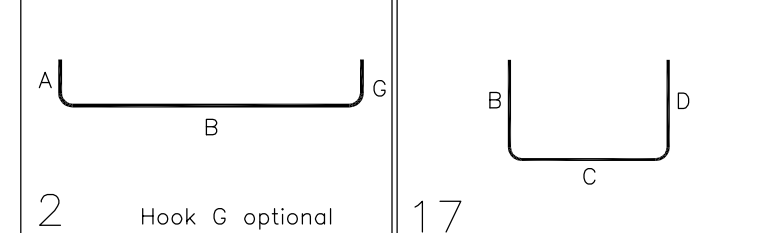

ABBREVIATIONS	
BOTTOM	B
TOP&BOTTOM	T&B
CONTINUOUS	CONT.
CORNER BAR	COR.
HORIZONTAL	H
EACH WAY	EW
EACH FACE	EF
INNER FACE	IF
OUTER FACE	OF
EACH SIDE	ES
DOWEL	DWL.
LONG WAY BAR	LW
SHORT WAY BAR	SW
REFERENCE	REF.

LAP SCHEDULE		
SIZE	4000 PSI	
	TOP	OTHERS
#4	20"	16"
#5	26"	20"
#6	30"	24"
#7	43"	33"
#8	50"	38"
#9	56"	42"
#10	62"	48"
#11	69"	54"

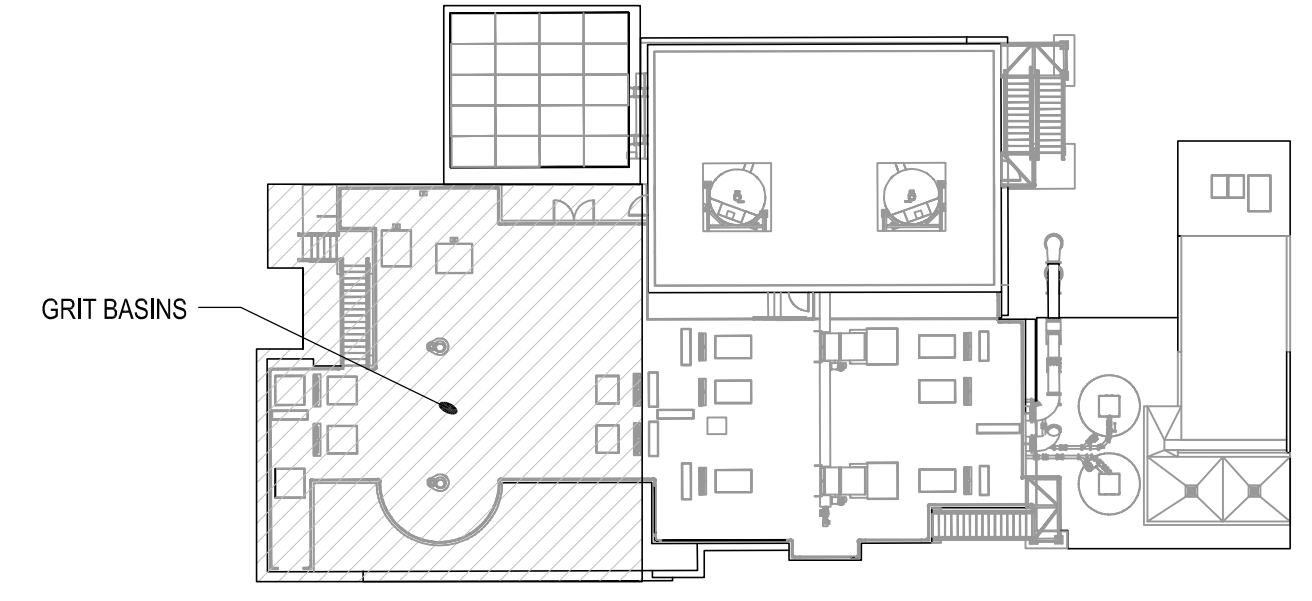


KEY PLAN
SCALE - N.T.S
REF:02-M-01-105

FIELD USE:
THIS DRAWING IS TO BE USED IN CONJUNCTION WITH THE REBAR CAD SOFTWARE. IT IS NOT TO BE USED FOR ANY OTHER PURPOSES. THE USER ASSUMES ALL RESPONSIBILITY FOR THE ACCURACY OF THE INFORMATION PROVIDED IN THIS DOCUMENT. THE USER ASSUMES ALL RESPONSIBILITY FOR THE ACCURACY OF THE INFORMATION PROVIDED IN THIS DOCUMENT. THE USER ASSUMES ALL RESPONSIBILITY FOR THE ACCURACY OF THE INFORMATION PROVIDED IN THIS DOCUMENT.

APPROVAL AUTHORITY:
ALL ITEMS THAT ARE REQUIRED TO BE MARKED WITH A PERCENT SIGN (%) IN THE CONTRACT DOCUMENTS, UNLESS OTHERWISE SPECIFIED, SHALL BE ASSUMED CORRECT AS SHOWN. THE USER ASSUMES ALL RESPONSIBILITY FOR THE ACCURACY OF THE INFORMATION PROVIDED IN THIS DOCUMENT. THE USER ASSUMES ALL RESPONSIBILITY FOR THE ACCURACY OF THE INFORMATION PROVIDED IN THIS DOCUMENT.



SUBMITTAL RECORD	
DATE	07/03/25
FOR	APPROVAL
DATE	
FOR	
DATE	
FOR	
DATE	09/09/25
FOR	REVISED AS PER A/E COMMENTS
DATE	
FOR	
DATE	
FOR	

PROJECT INFORMATION	
CUSTOMER	2524240001
JOB NAME	HULO WHP
DETAILS	WILLIAMSONREBAR.COM
EMAIL	
PHONE	(360)-346-6723
LOCATION	COUNTY OF HAWAII
DESCRIPTION	GRIT BASINS - BASE SLAB REINFORCEMENT DETAILS
NOTED	

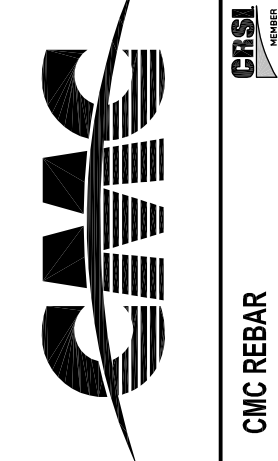


JOB# 2524240001
DRAWING: RP-15

ALL REINFORCEMENTS ARE A615 GR.60 U.N.O

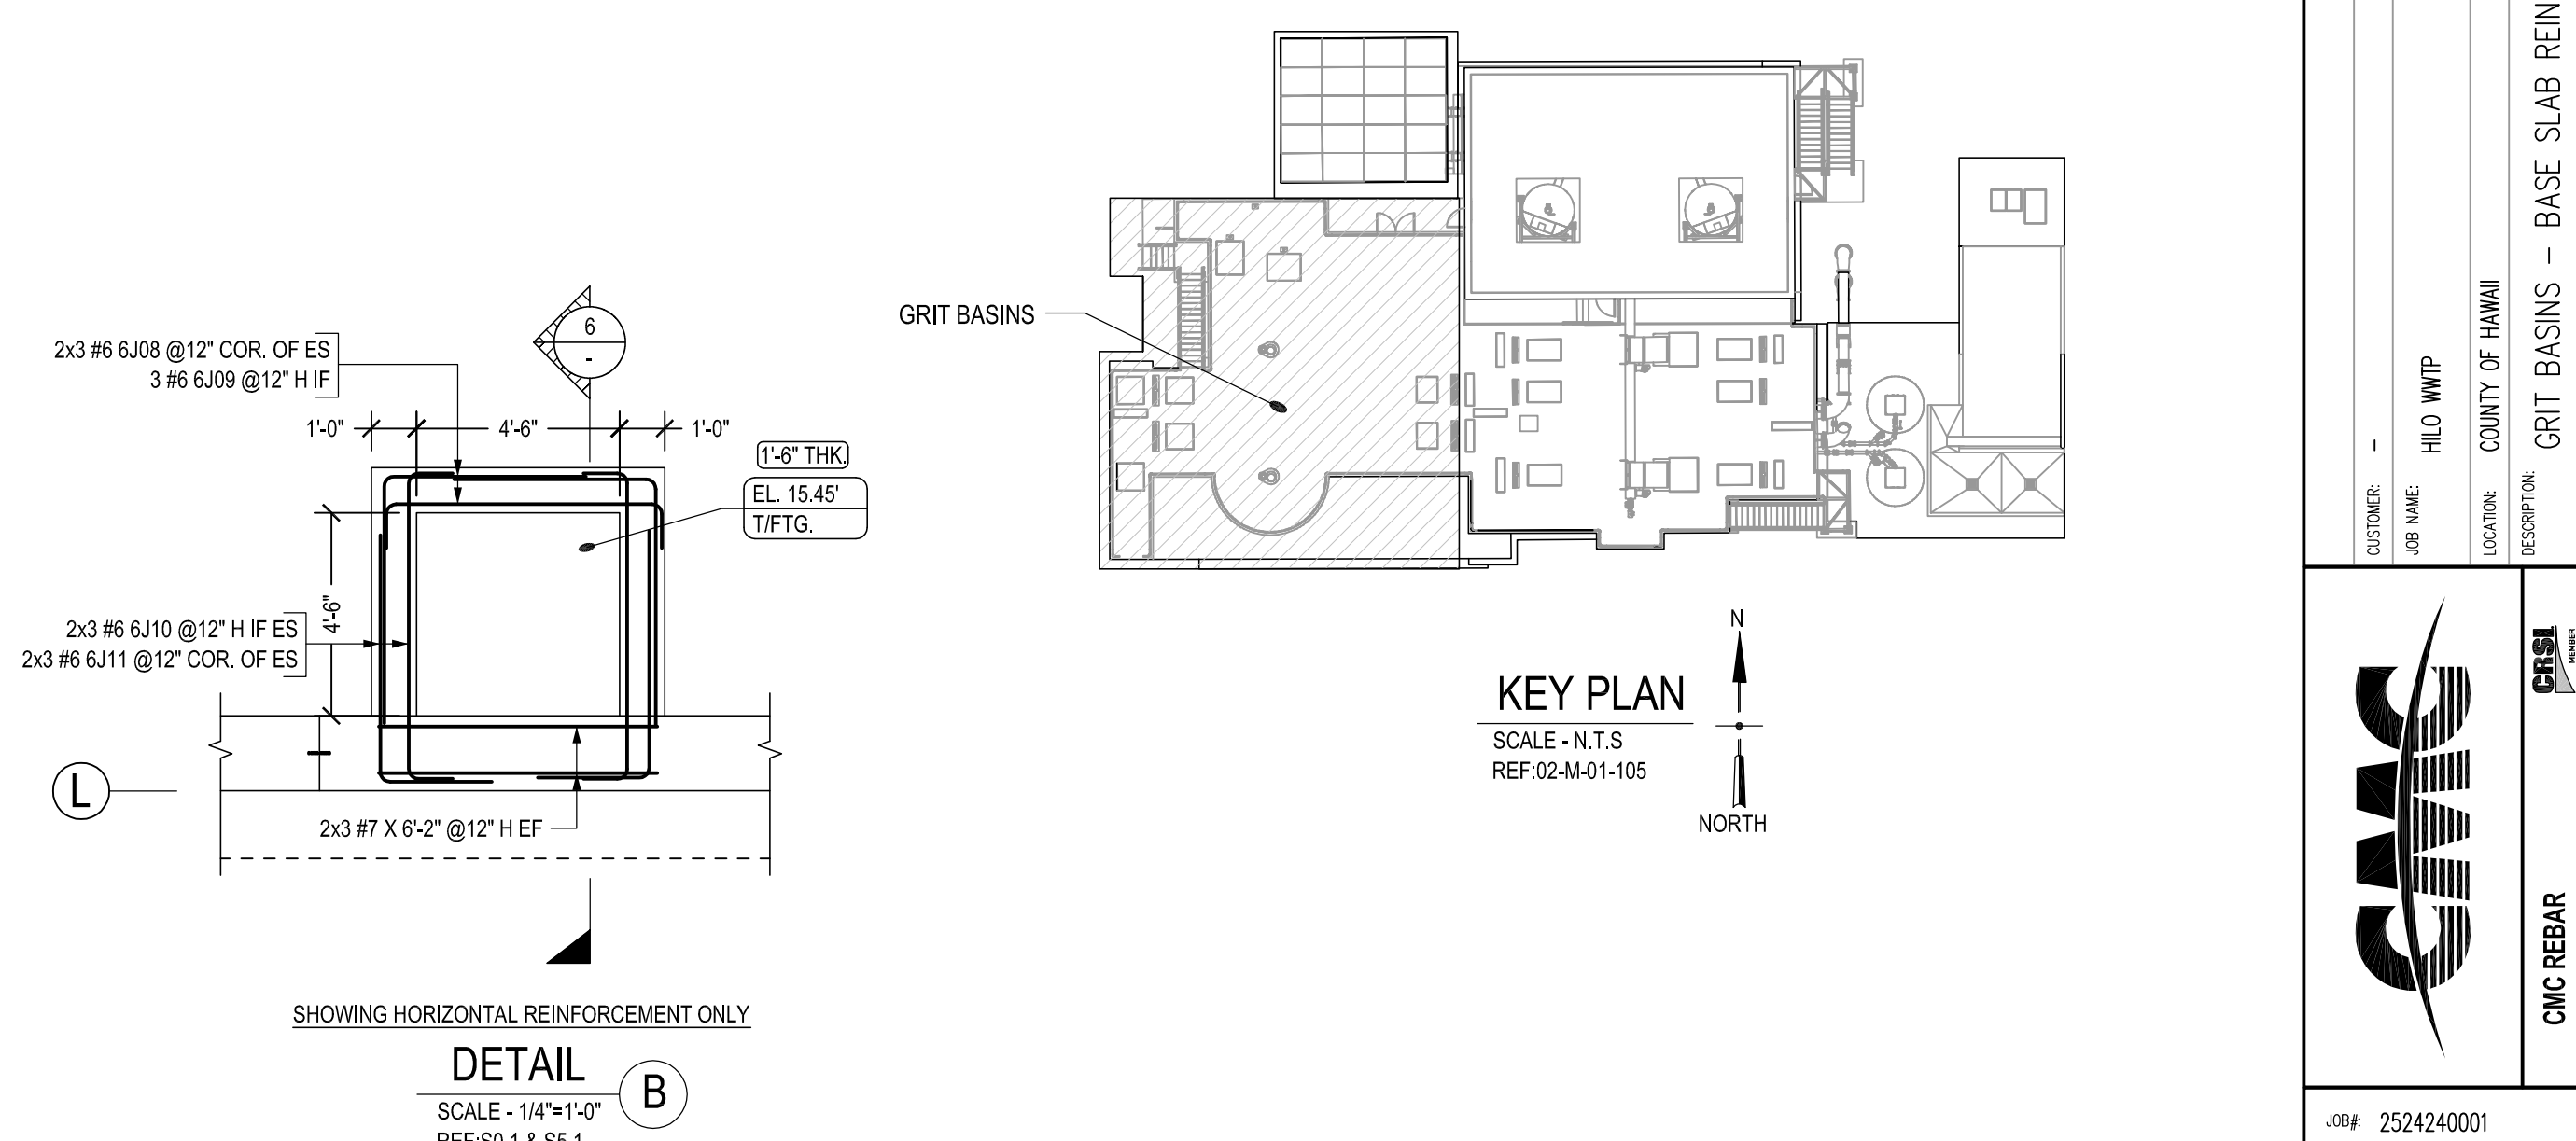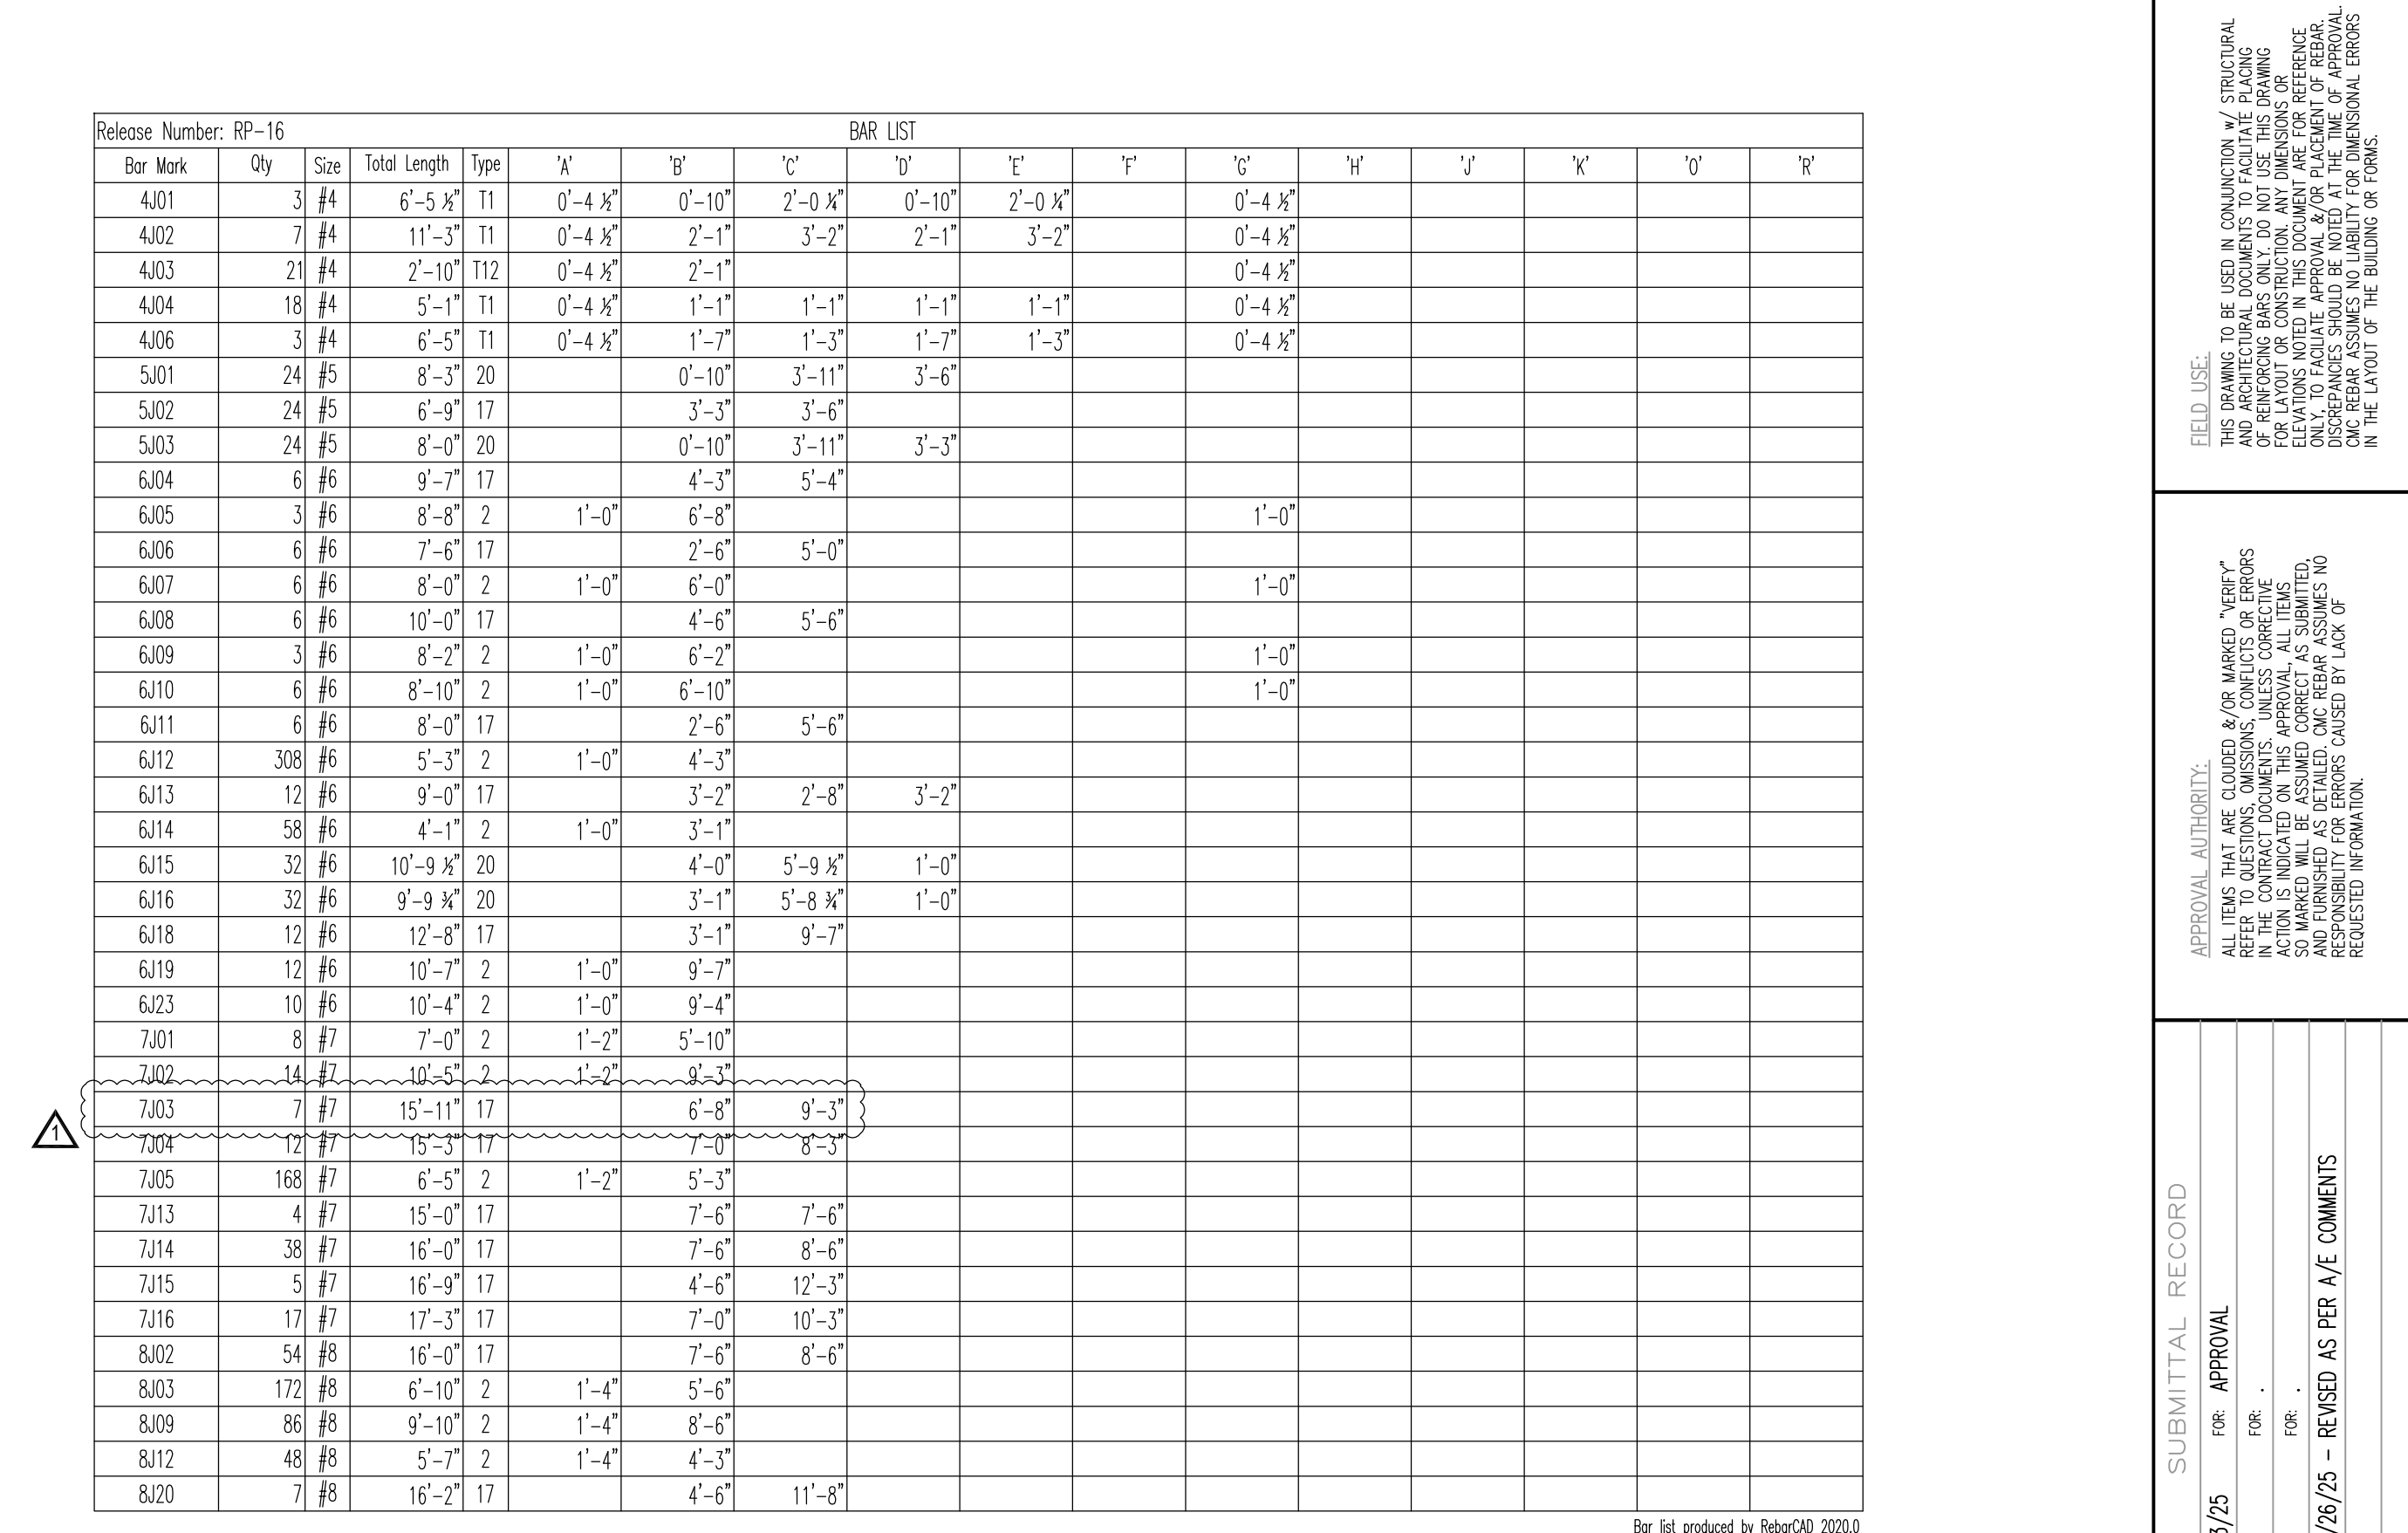

ALL REINFORCEMENTS ARE A615 GR.60 U.N.O



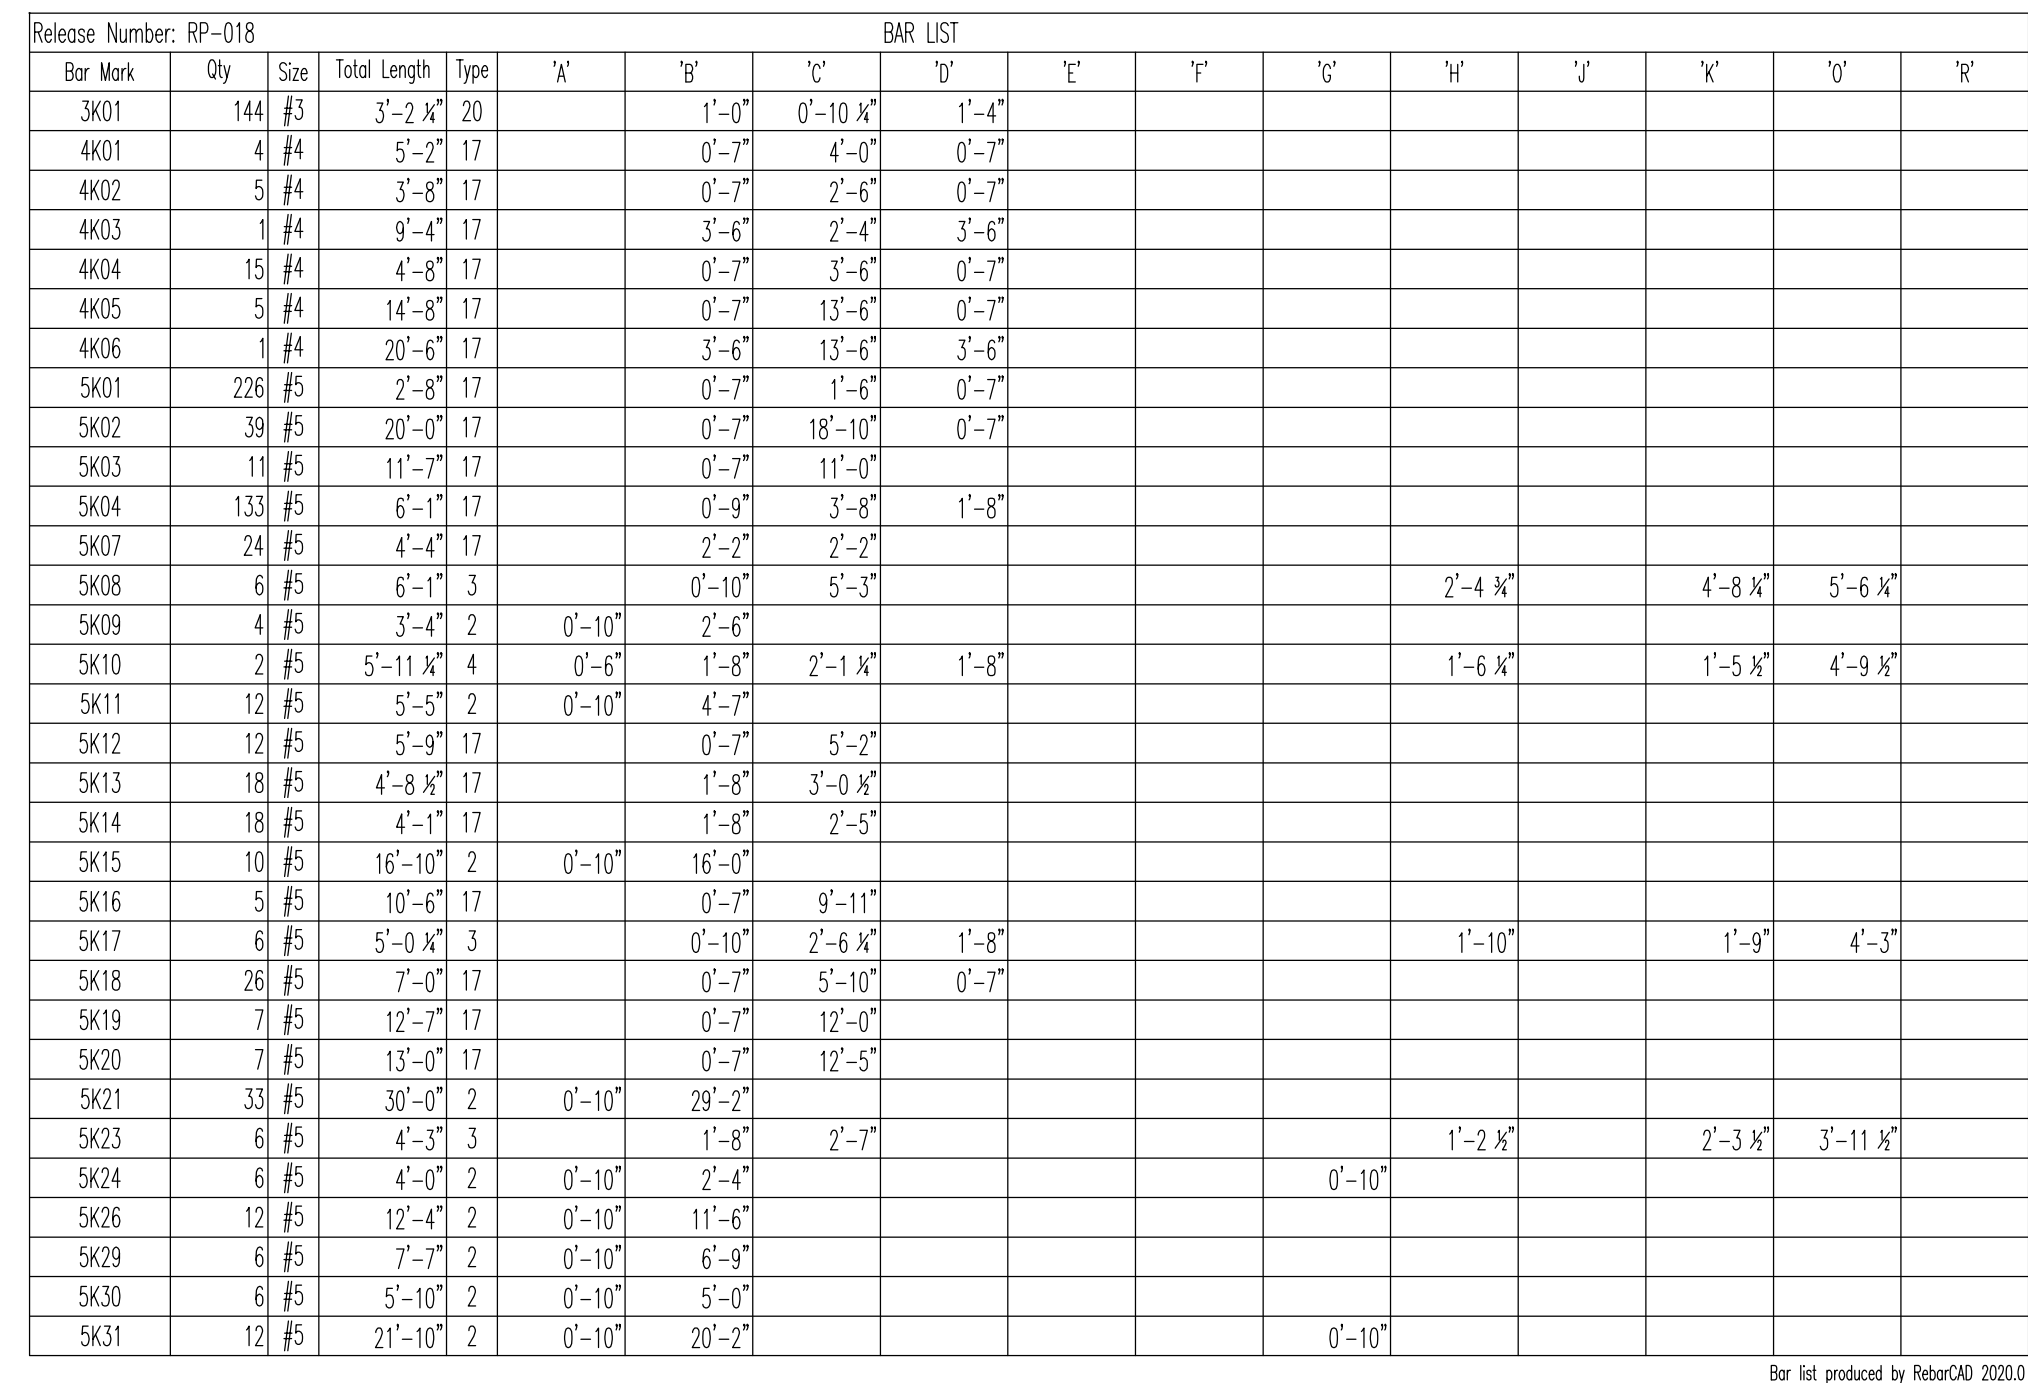

20	17	3 Hooks A & G optional	2 Hook G optional	4 Hook G optional
-----------	-----------	-----------------------------------	--------------------------	--------------------------

ABBREVIATIONS	
BOTTOM	B
TOP&BOTTOM	T&B
CONTINUOUS	CONT.
CORNER BAR	COR.
HORIZONTAL	H
EACH WAY	EW
EACH FACE	EF
INNER FACE	IF
OUTER FACE	OF
EACH SIDE	ES
DOWEL	DWL.
LONG WAY BAR	LW
SHORT WAY BAR	SW
REFERENCE	REF.

LAP SCHEDULE		
SIZE	4000 PSI	
	TOP	OTHERS
#4	20"	16"
#5	26"	20"
#6	30"	24"
#7	43"	33"
#8	50"	38"
#9	56"	42"
#10	62"	48"
#11	69"	54"

LAP SCHEDULE	
REF: (S400)	
(FOR MASONRY WALLS)	
SIZE	CENTERED IN WALL
#4	18"
#5	27"
#6	50"
#7	69"
#8	108"



FIELD USE: THIS DRAWING TO BE USED IN CONJUNCTION w/ STRUCTURAL AND ARCHITECTURAL DOCUMENTS TO FACILITATE PLACING OF REINFORCING BARS ONLY. DO NOT USE THIS DRAWING FOR LAYOUT OR CONSTRUCTION. ANY DIMENSIONS OR ELEVATIONS NOTED IN THIS DOCUMENT ARE FOR REFERENCE ONLY. TO FACILITATE APPROVAL &/OR PLACEMENT OF REBAR, DISCREPANCIES SHOULD BE NOTED AT THE TIME OF APPROVAL. CMC REBAR ASSUMES NO LIABILITY FOR DIMENSIONAL ERRORS.

APPROVAL AUTHORITY: ALL ITEMS THAT ARE CLOUDED &/OR MARKED "VERIFY" REFER TO QUESTIONS, OMISSIONS, CONFLICTS OR ERRORS IN THE CONTRACT DOCUMENTS. UNLESS CORRECTIVE ACTION IS INDICATED ON THIS APPROVAL, ALL ITEMS SO MARKED WILL BE ASSUMED CORRECT AS SUBMITTED, AND FURNISHED AS DETAILED. CMC REGAR ASSUMES NO RESPONSIBILITY FOR ERRORS CAUSED BY LACK OF REQUESTED INFORMATION.

FOR: APPROVAL

DATE: 07/11/2017
DATE: .
DATE: .
1 DATE: 07/11/2017
2 DATE: .


PROJECT INFORMATION

CUSTOMER:	
JOB NAME:	
LOCATION:	
DESCRIPTION:	




JOB# 2524240001


DRAWING:
RP-018

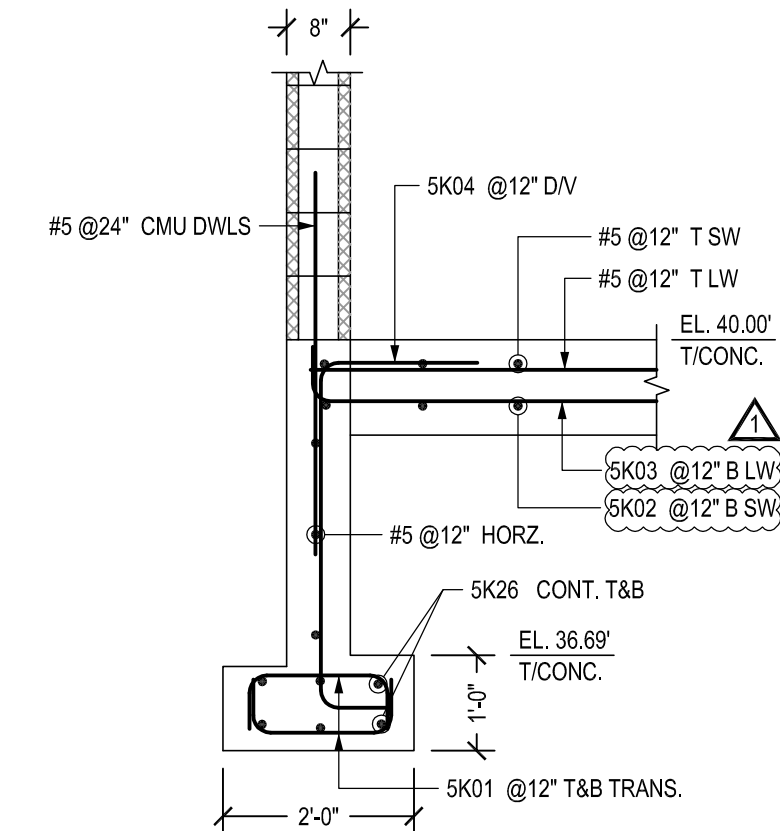

SECTION 6
SCALE - 1/2"=1'-0"
REF:3/25-S-01-501

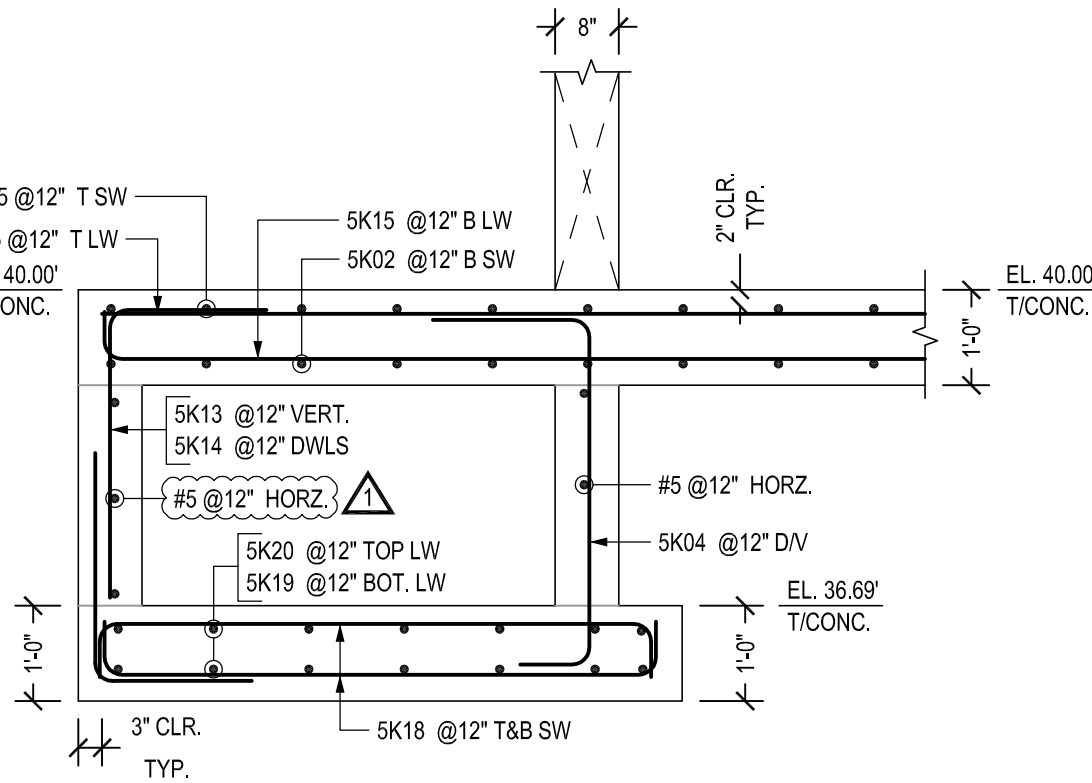


SECTION 4
SCALE - 1/2"=1'-0"
REF:1/25-S-01-501

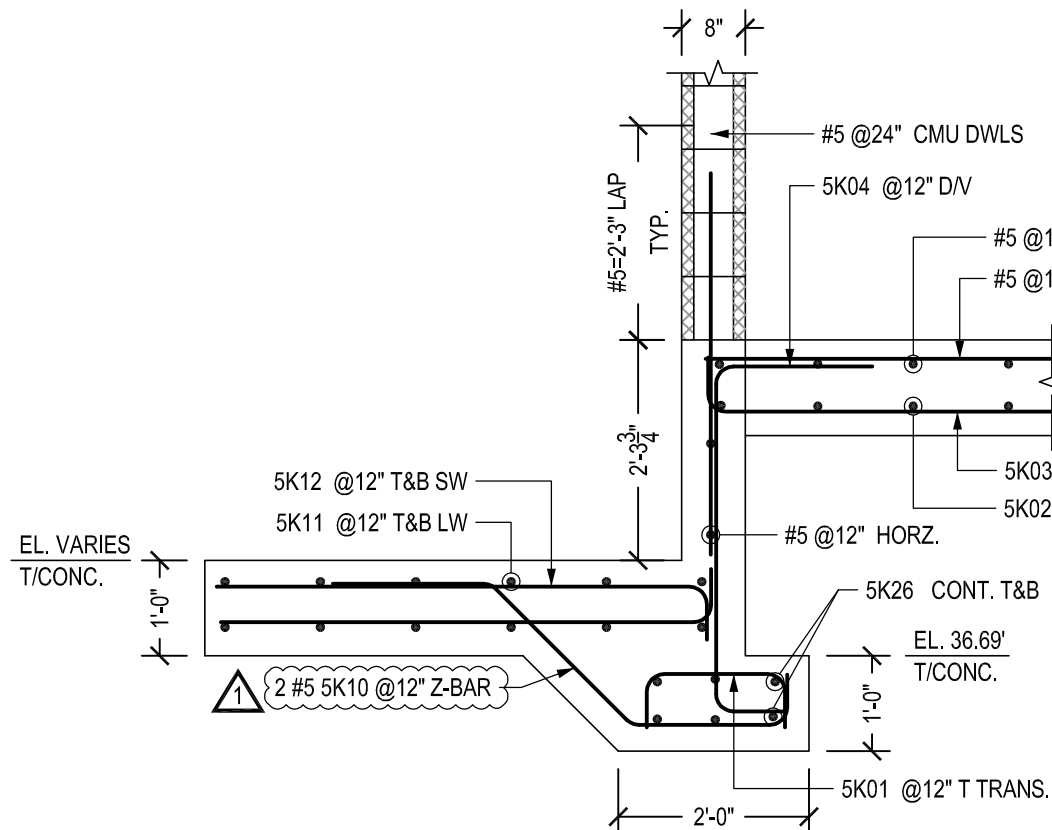


ALL REINFORCEMENTS ARE A615 GR.60 U.N.O

RP-019

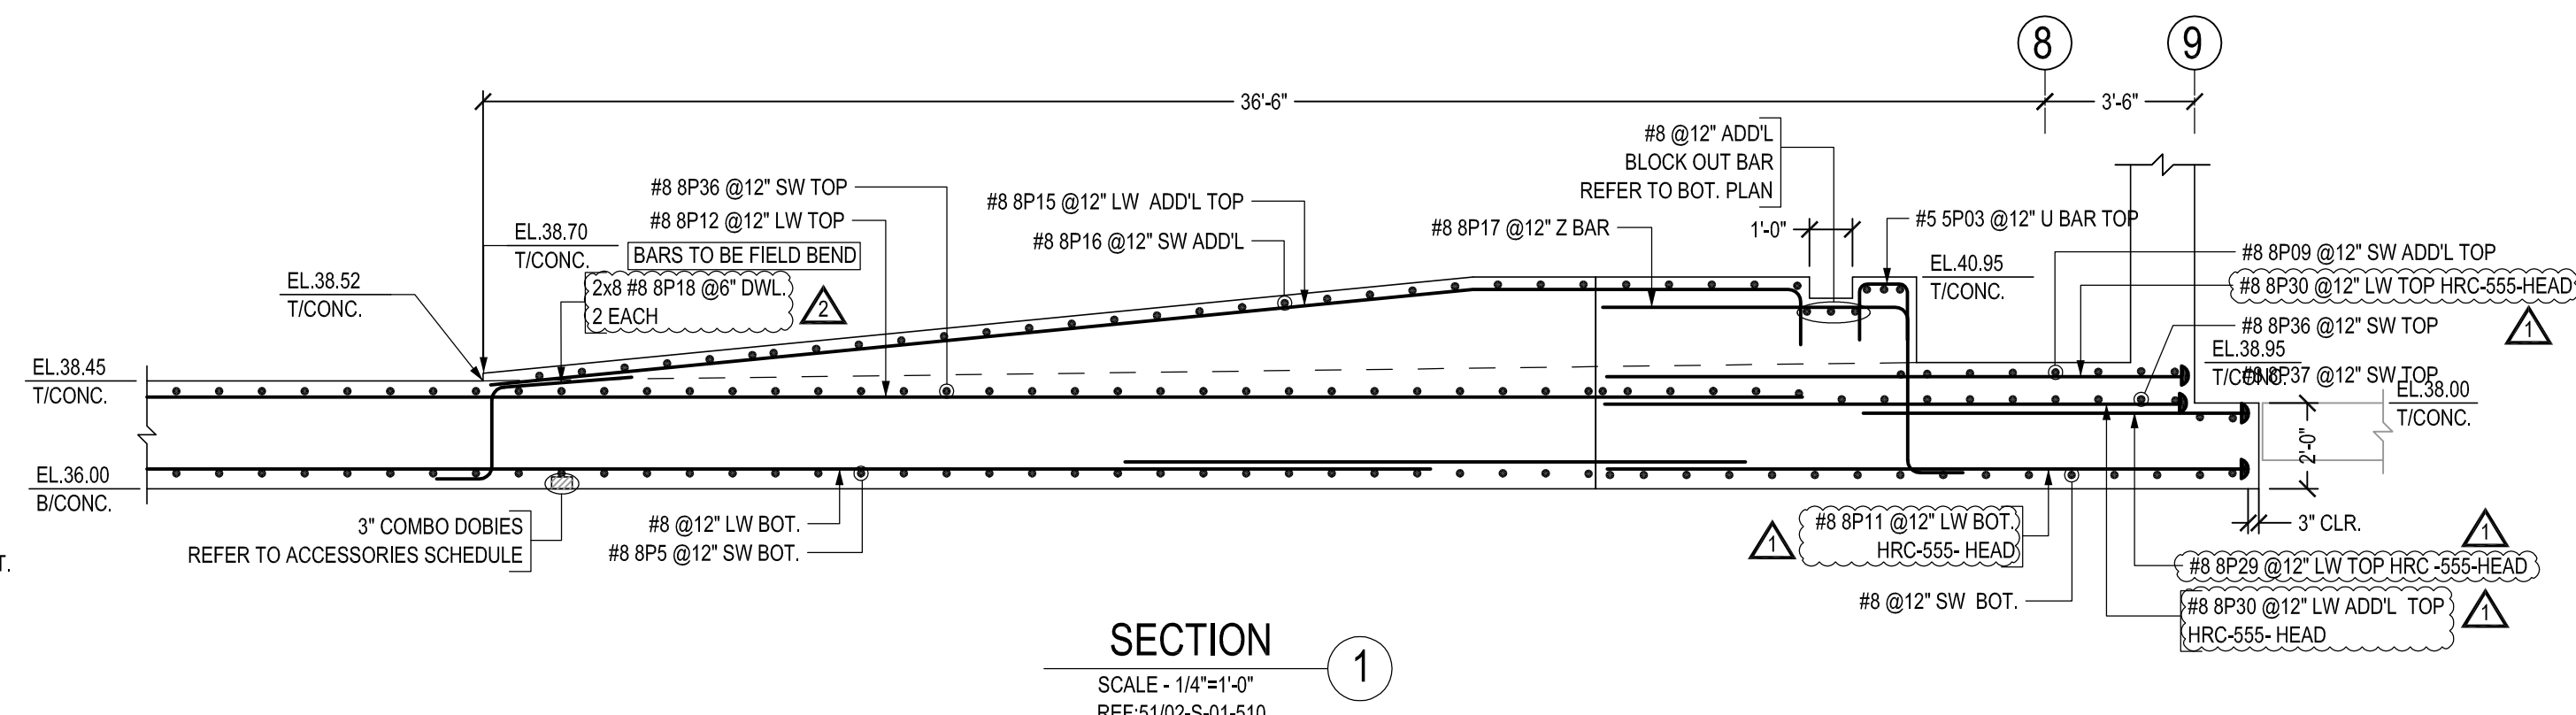



SCALE - 1/4"=1'-0"
REF:02-S-01-103, TO S2-S-01-302
02-S-01-501 TO 02-S-01-510

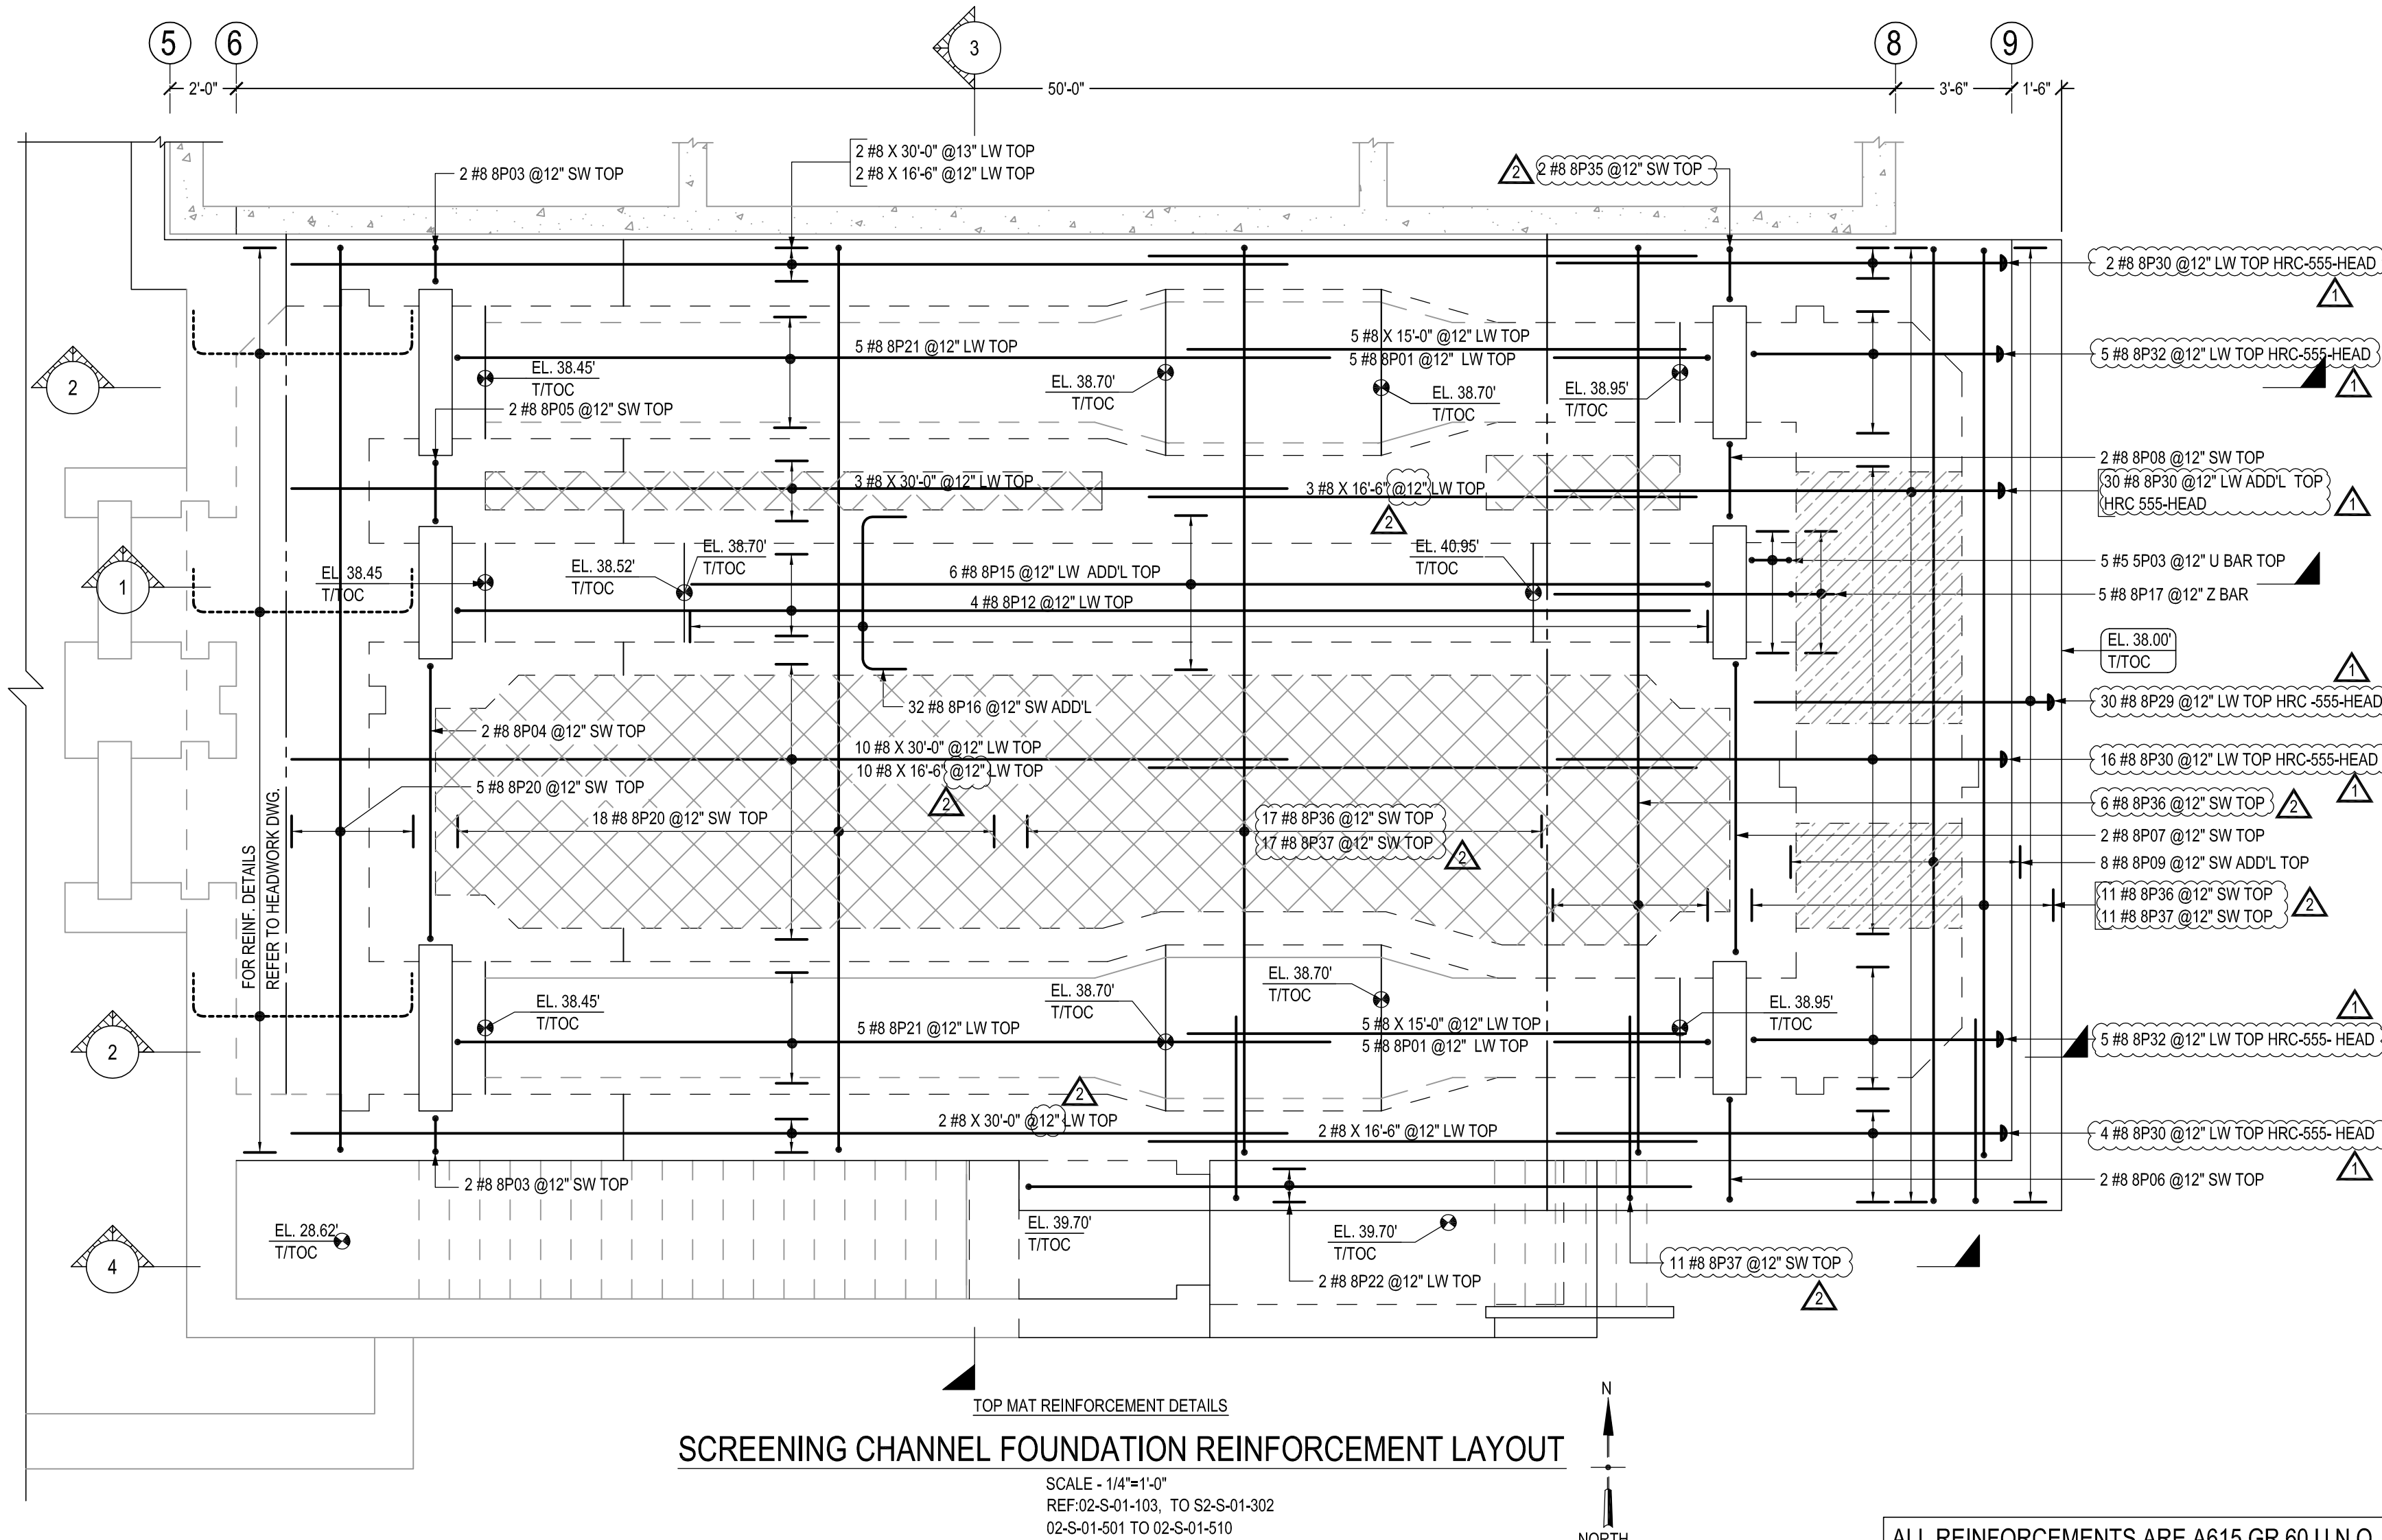


SCALE - 1/4"=1'-0"
REF:02-S-01-103, TO S2-S-01-302
02-S-01-501 TO 02-S-01-510

ALL REINFORCEMENTS ARE A615 GR.60 U.N.O

	JOB# 2424620061		DRAWING: RP-022	
	CUSTOMER:	JOB NAME:	LOCATION:	DESCRIPTION:
PROJECT INFORMATION				
JOB # 2424620061 DATE: 07/25/25 TIME: 10:00 AM DRAWN BY: MFR CHECKED BY: MFR EMAIL: will@transiterror.com PHONE: (360) - 546-6729	SUBMITTAL RECORD DATE: 07/25/25 TIME: 10:00 AM DRAWN BY: MFR CHECKED BY: MFR EMAIL: will@transiterror.com PHONE: (360) - 546-6729	APPROVAL AUTHORITY: ALL ITEMS THAT ARE CIRCLED &/OR MARKED "JERRY" REFER TO QUESTIONS, OMISSIONS, CORRECTIONS OR ERRORS. ACTION IS REQUESTED BY THE SUBMITTER. NO ACTION IS REQUIRED ON THE APPROVAL. ALL ITEMS SO MARKED WILL BE ASSUMED CORRECT AS SUBMITTED. THE SUBMITTER WILL BE RESPONSIBLE FOR ANY DISCREPANCIES SHOULD BE NOTED AT THE TIME OF APPROVAL IN THE LAUDIT OF THE BUILDING OF FORMS.	FIELD USE: THIS DRAWING TO BE USED IN CONNECTION WITH STRUCTURAL AND ARCHITECTURAL DOCUMENTS TO FACILITATE PLACING AND ERECTING OF CONCRETE. NO OTHER USES ARE PERMITTED FOR LAYOUT OF CONSTRUCTION. ANY DIMENSIONS OR NOTATIONS NOTED IN THIS DRAWING ARE FOR REFERENCE ONLY. THE SUBMITTER WILL BE RESPONSIBLE FOR ANY DISCREPANCIES SHOULD BE NOTED AT THE TIME OF APPROVAL IN THE LAUDIT OF THE BUILDING OF FORMS.	

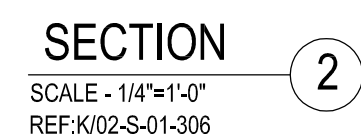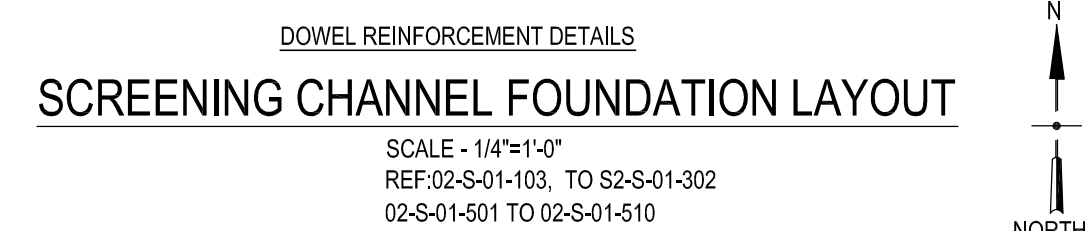

Release Code: RP-022 _RP-024				BENDING DETAILS.											
Bar Mark	Qty	Size	Total lengthType	'A'	'B'	'C'	'D'	'E'	'F'	'G'	'H'	'J'	'K'	'L'	'M'
SP1	5	#5	21'0" 2	10"	20'2"										
SP2	5	#5	20'5 1/2" 2	10"	19'7 1/2"										
BP5	23	#8	28'7" 2	14"	27'3"										
BP1	17	#8	30'1" 2	14"	28'9"										
SP01	106	#5	7'3" P01		16"	18 1/2"	10"	18 1/2"	16"						
SP02	4	#5	5'6" P01		16"	10"	10"	10"	16"						
SP03	5	#5	3'10" 17		14"	12"	14"								
SP04	5	#5	3'4" 3		18"	18"					11 1/2"		15"	31"	
SP05	42	#5	8'6" 2	10"	6'10"					10"					
6P01	510	#6	6'2" 2	10"	5'2"										
6P02	10	#6	4'6" 2	10"	3'6"										
6P03	17	#6	6'2 1/2" 15		17"	8 1/2"	11 1/2"	11 1/2"			1"	14 1/2"	14 1/2"	20 1/2"	
6P04	6	#6	9'11 1/2" 3		7'11 1/2"	2'0"					11 1/2"		18"	9'3 1/2"	
6P05	8	#6	5'6" 17		3'6"	2'0"									
6P07	16	#6	4'0" 2	10"	3'0"										
6P08	16	#6	4'4" 2	10"	3'4"										
7P01	62	#7	6'10" 2	12"	5'8"										
BP01	10	#8	6'0" 17		4'8"	14"									
BP03	4	#8	3'9" 2	14"	1"					14"					
BP04	2	#8	10'11 1/2" 2	14"	8'3 1/2"					14"					
BP05	2	#8	4'6" 2	14"	1'10"					14"					
BP06	2	#8	5'9" 2	14"	3'1"					14"					
BP07	2	#8	1'15" 2	14"	8'9"					14"					
BP08	2	#8	4'11" 2	14"	2'3"					14"					
BP09	8	#8	3'15" 2	14"	28'9"					14"					
BP11	30	#8	15'1" HC1		15'1"										
BP12	4	#8	38'6" 2	14"	37'2"										
BP13	81	#8	9'3" 17		6'1"	3'2"									
BP14	90	#8	7'5" 2	14"	6'1"										
BP15	6	#8	32'14	14"	78 1/2"	23'0 1/2"					23 1/2"		22'11 1/2"	30'7 1/2"	
BP16	32	#8	7'4" 2	14"	4'8"					14"					
BP17	5	#8	12'5 1/2" 20		14"	3'11 1/2"	7'2"								
BP18	16	#8	6'9 1/2" 20		14"	2'2 1/2"	3'3"								
BP20	23	#8	29'11" 2	14"	27'3"					14"					
BP21	10	#8	27'8" 2	14"	26'4"										
BP22	2	#8	2'14" 2	14"	20'0"										
BP23	2	#8	20'4" 2	14"	19'0"										
BP24	3	#8	16'10" 2	14"	15'6"										
BP25	3	#8	10'8" 2	14"	9'4"										
BP26	3	#8	10'1" 2	14"	8'9"										
BP27	3	#8	11'4" 2	14"	10'0"										
BP29	30	#8	9'0" HC1		9'0"										
BP30	52	#8	13'7" HC1		13'7"										
BP32	10	#8	8'11" HC3	14"	7'7"										
BP33	56	#8	6'6" 2	10"	5'6"										
BP35	2	#8	4'3" 2	14"	17"						14"				
BP36	34	#8	30'0" 2	14"	27'4"					14"					
BP37	39	#8	6'10" 2	14"	5'6"										

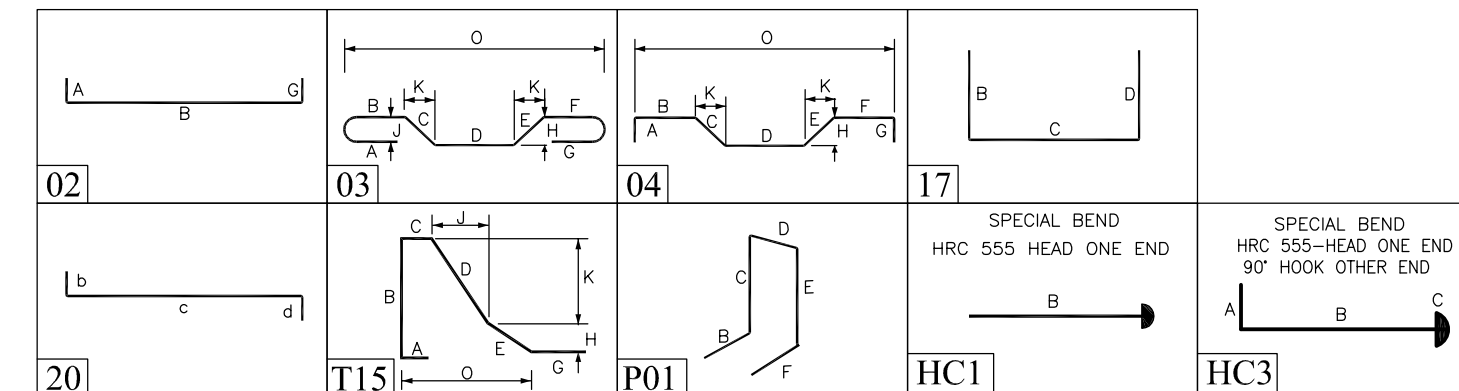

LAP SCHEDULE		
REF:1110/00-T-03-701		
SIZE	4000 PSI	
	TOP	OTHERS
#4	20"	16"
#5	26"	20"
#6	30"	24"
#7	43"	33"
#8	50"	38"
#9	56"	42"
#10	62"	48"

ABBREVIATIONS	
BOTTOM	BOT.
TOP/ABOTTOM	T&B
CONTINUOUS	CONT
FACE BAR	-
CORNER BAR	COR.
VERTICAL	VERT.
HORIZONTAL	HORZ.
STIRRUPS	STPS
EACH WAY	EW
EACH FACE	EF
INNER FACE	IF
OUTER FACE	OF
EACH SIDE	ES
EACH END	EE
DOWEL	DWL.
DOWEL/VERTICAL	D/V
TRANSVERSE	TRANS.
LONG WAY BAR	LW
SHORT WAY BAR	SW
DRILL & EPOXY	D&E
REFERENCE	REF.

ACCESSORIES	
HEIGHT	QUANTITY
3" COMBO DOBIES (5000 PSI)	120 NOS. @4'-0" C/C.

THIS DRAWING TO BE USED IN CONJUNCTION w/ STRUCTURAL AND ARCHITECTURAL DOCUMENTS TO FACILITATE PLACING OF REINFORCING BARS ONLY. DO NOT USE THIS DRAWING FOR LAYOUT OR CONSTRUCTION. ANY DIMENSIONS OR ELEVATIONS NOTED IN THIS DOCUMENT ARE FOR REFERENCE ONLY. TO FACILITATE APPROVAL & FOR PLACEMENT OF REBAR, DIMENSIONS SHOULD BE NOTED AT THE TIME OF APPROVAL. THE REBAR ASSUMES NO LIABILITY FOR DIMENSIONAL ERRORS IN THE DRAWING OR THE BUILDING OR FORMS.

APPROVAL AUTHORITY: ALL ITEMS THAT ARE CLOUDED &/OR MARKED "VERIFY" WILL REFER TO QUESTIONS, OMISSIONS, CONFLICTS OR ERRORS IN THE CONTRACT DOCUMENTS UNLESS CORRECTIVE ACTION IS INDICATED ON THIS APPROVAL ALL ITEMS TO BE MARKED WILL BE ASSUMED CORRECT AS SUBMITTED, AND FURNISHED AS DETAILED. CMC REBAR ASSUMES NO RESPONSIBILITY FOR ERRORS CAUSED BY LACK OF REQUESTED INFORMATION.


SUBMITTAL RECORD

	DATE:	FOR:
1.	07/31/25	APPROVAL
2.		
3.		
JOB #	2424620061
DETAILS:	MKR
EMAIL:	will@mcmasterbar.com
PHONE:	(360)-346-6729
REF:	02-S-01-103 TO 307 & 501

PROJECT INFORMATION
EL MAT SLAB REINFORCING





CUSTOMER:	
JOB NAME:	HILO WWTP
LOCATION:	COUNTY OF HAWAII
DESCRIPTION:	HEAD WORKS

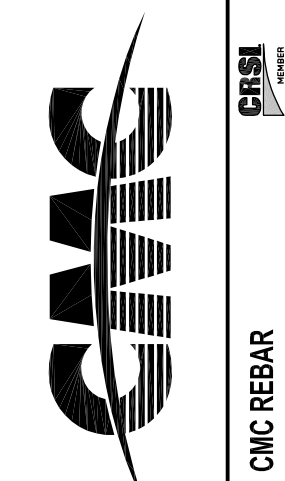


JOB# 2424620061

COATING

ALL REINFORCEMENTS ARE A615 GR.60 U.N.O

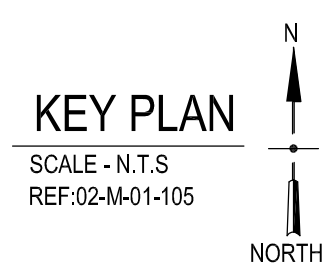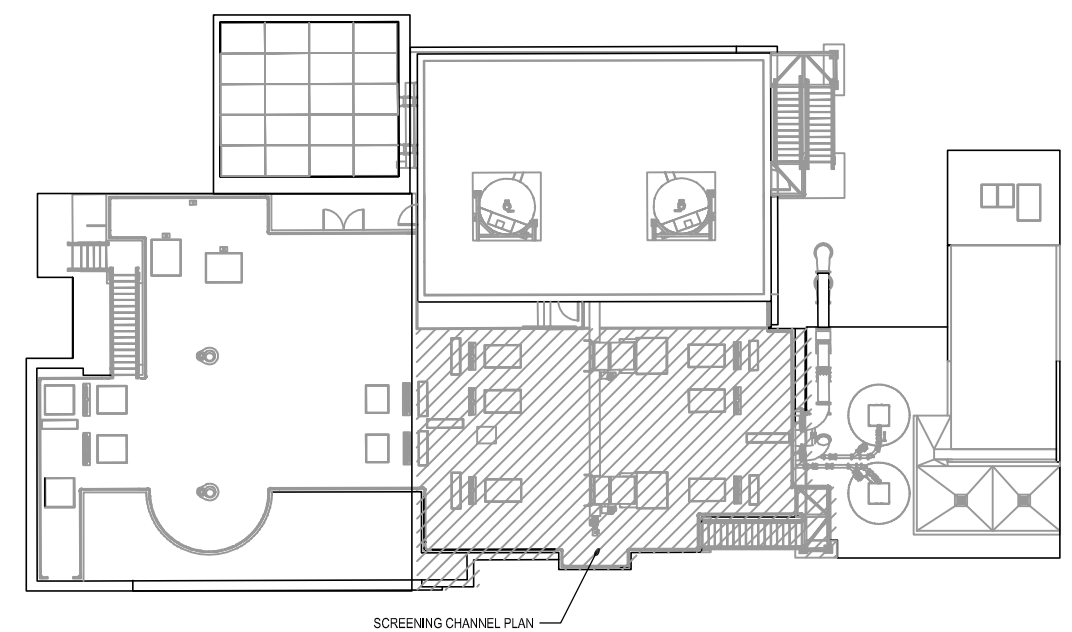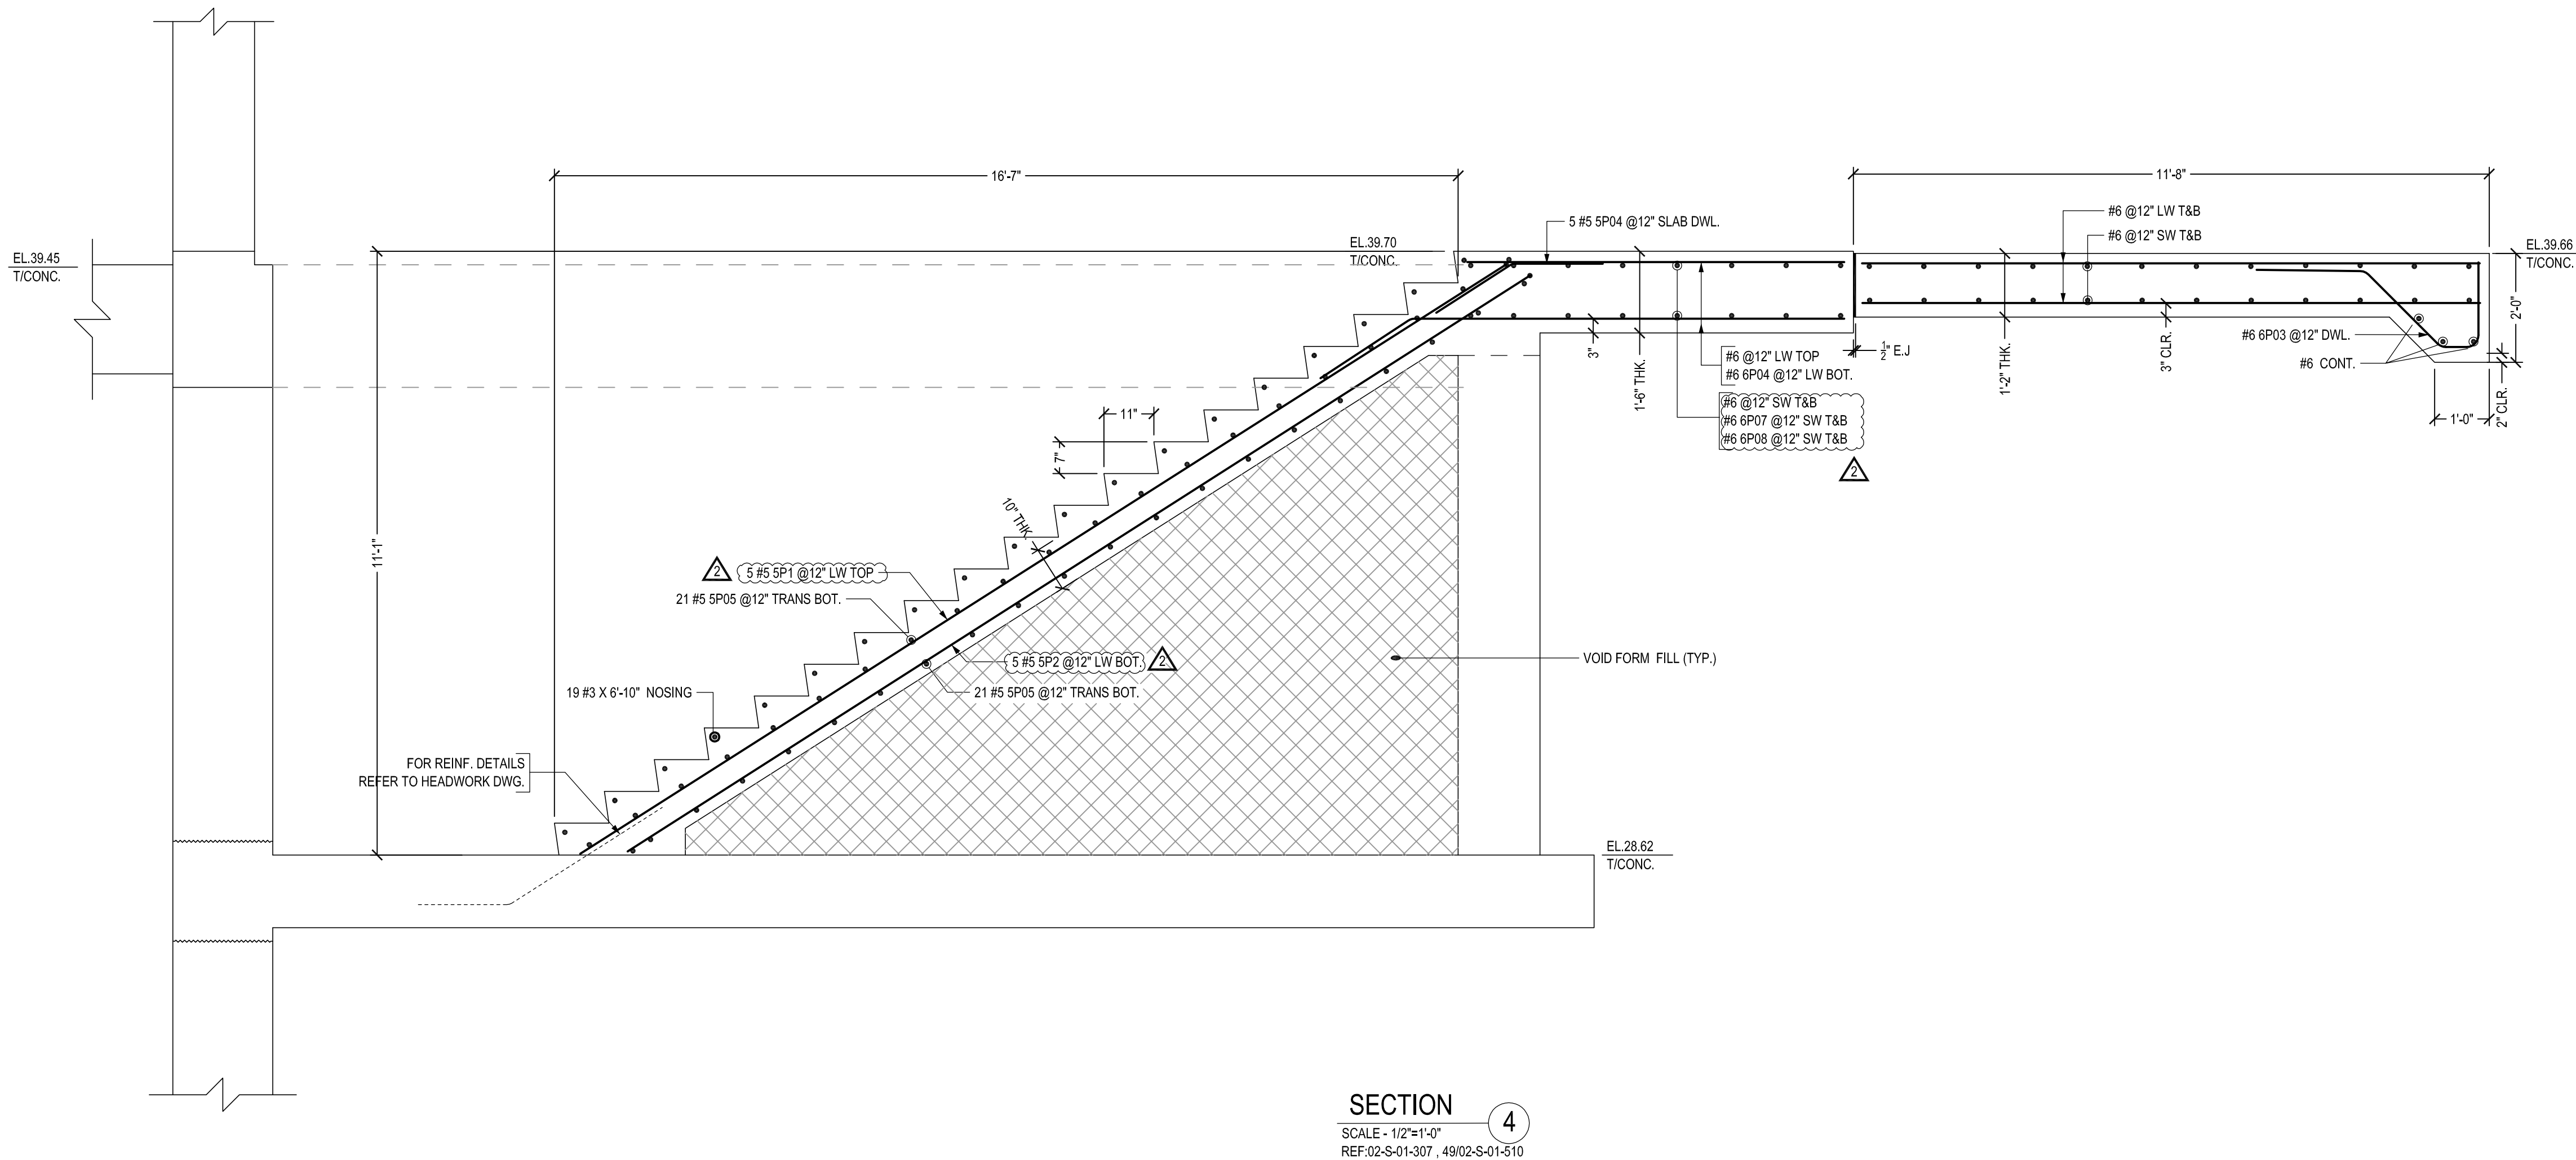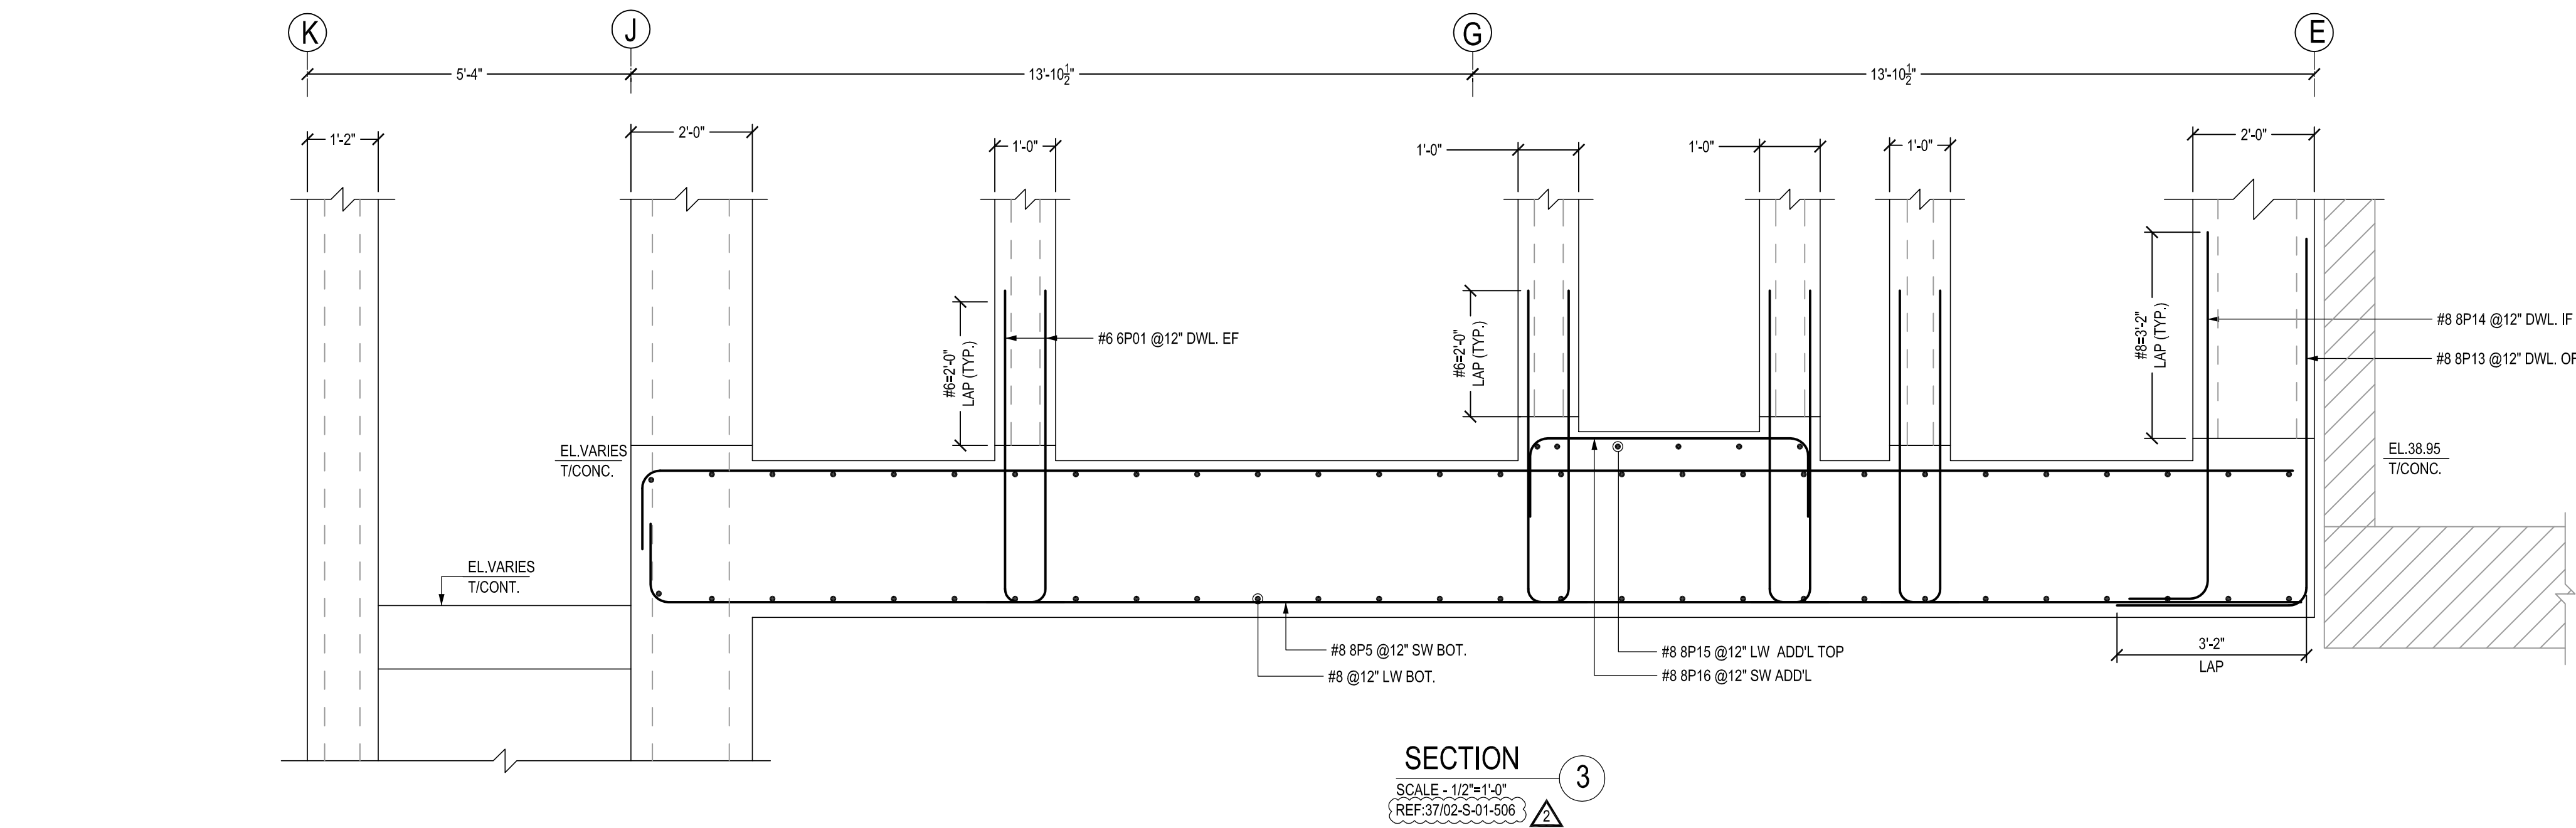

ALL REINFORCEMENTS ARE A615 GR.60 U.N.O

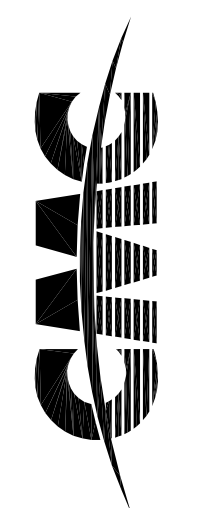	PROJECT INFORMATION		SUBMITTAL RECORD		APPROVAL AUTHORITY ALL ITEMS THAT ARE REQUIRED &/OR MARKED "PER" IN THE CONTRACT DOCUMENTS, UNLESS CORRECTIVE SO MARKED WILL BE ASSUMED CORRECT AS SHOWN. NO RESPONSIBILITY FOR ERRORS CAUSED BY A LACK OF REQUESTED INFORMATION.	FIELD USE THIS DRAWING IS TO BE USED IN CONSTRUCTION OF STRUCTURAL REINFORCING ONLY. DO NOT USE THIS DRAWING FOR ANY OTHER PURPOSES. ELEVATIONS NOTED IN THIS DOCUMENT ARE FOR REFERENCE ONLY. ANY DISCREPANCIES SHOULD BE NOTED AT THE TIME OF APPROVAL IN THE REPORT OF THE BUILDING OFFICE.
	CUSTOMER: HILLO WTP JOB NAME: COUNTY OF HAWAII LOCATION: SCREENING CHANNEL FOUNDATION REINFORCING	JOB # 2424620061 DETAILER: MTR EMAIL: will@mcsterritorbar.com PHONE: (360)-346-6729	DATE 07/31/25 FOR APPROVAL DATE . FOR . DATE . FOR . DATE 08/28/25 - REVISED AS PER MAIL INSTRUCTION DATE 09/24/25 -FOR REVISED AS PER A/E COMMENTS	DATE 07/31/25 FOR APPROVAL DATE . FOR . DATE . FOR . DATE 08/28/25 - REVISED AS PER MAIL INSTRUCTION DATE 09/24/25 -FOR REVISED AS PER A/E COMMENTS		